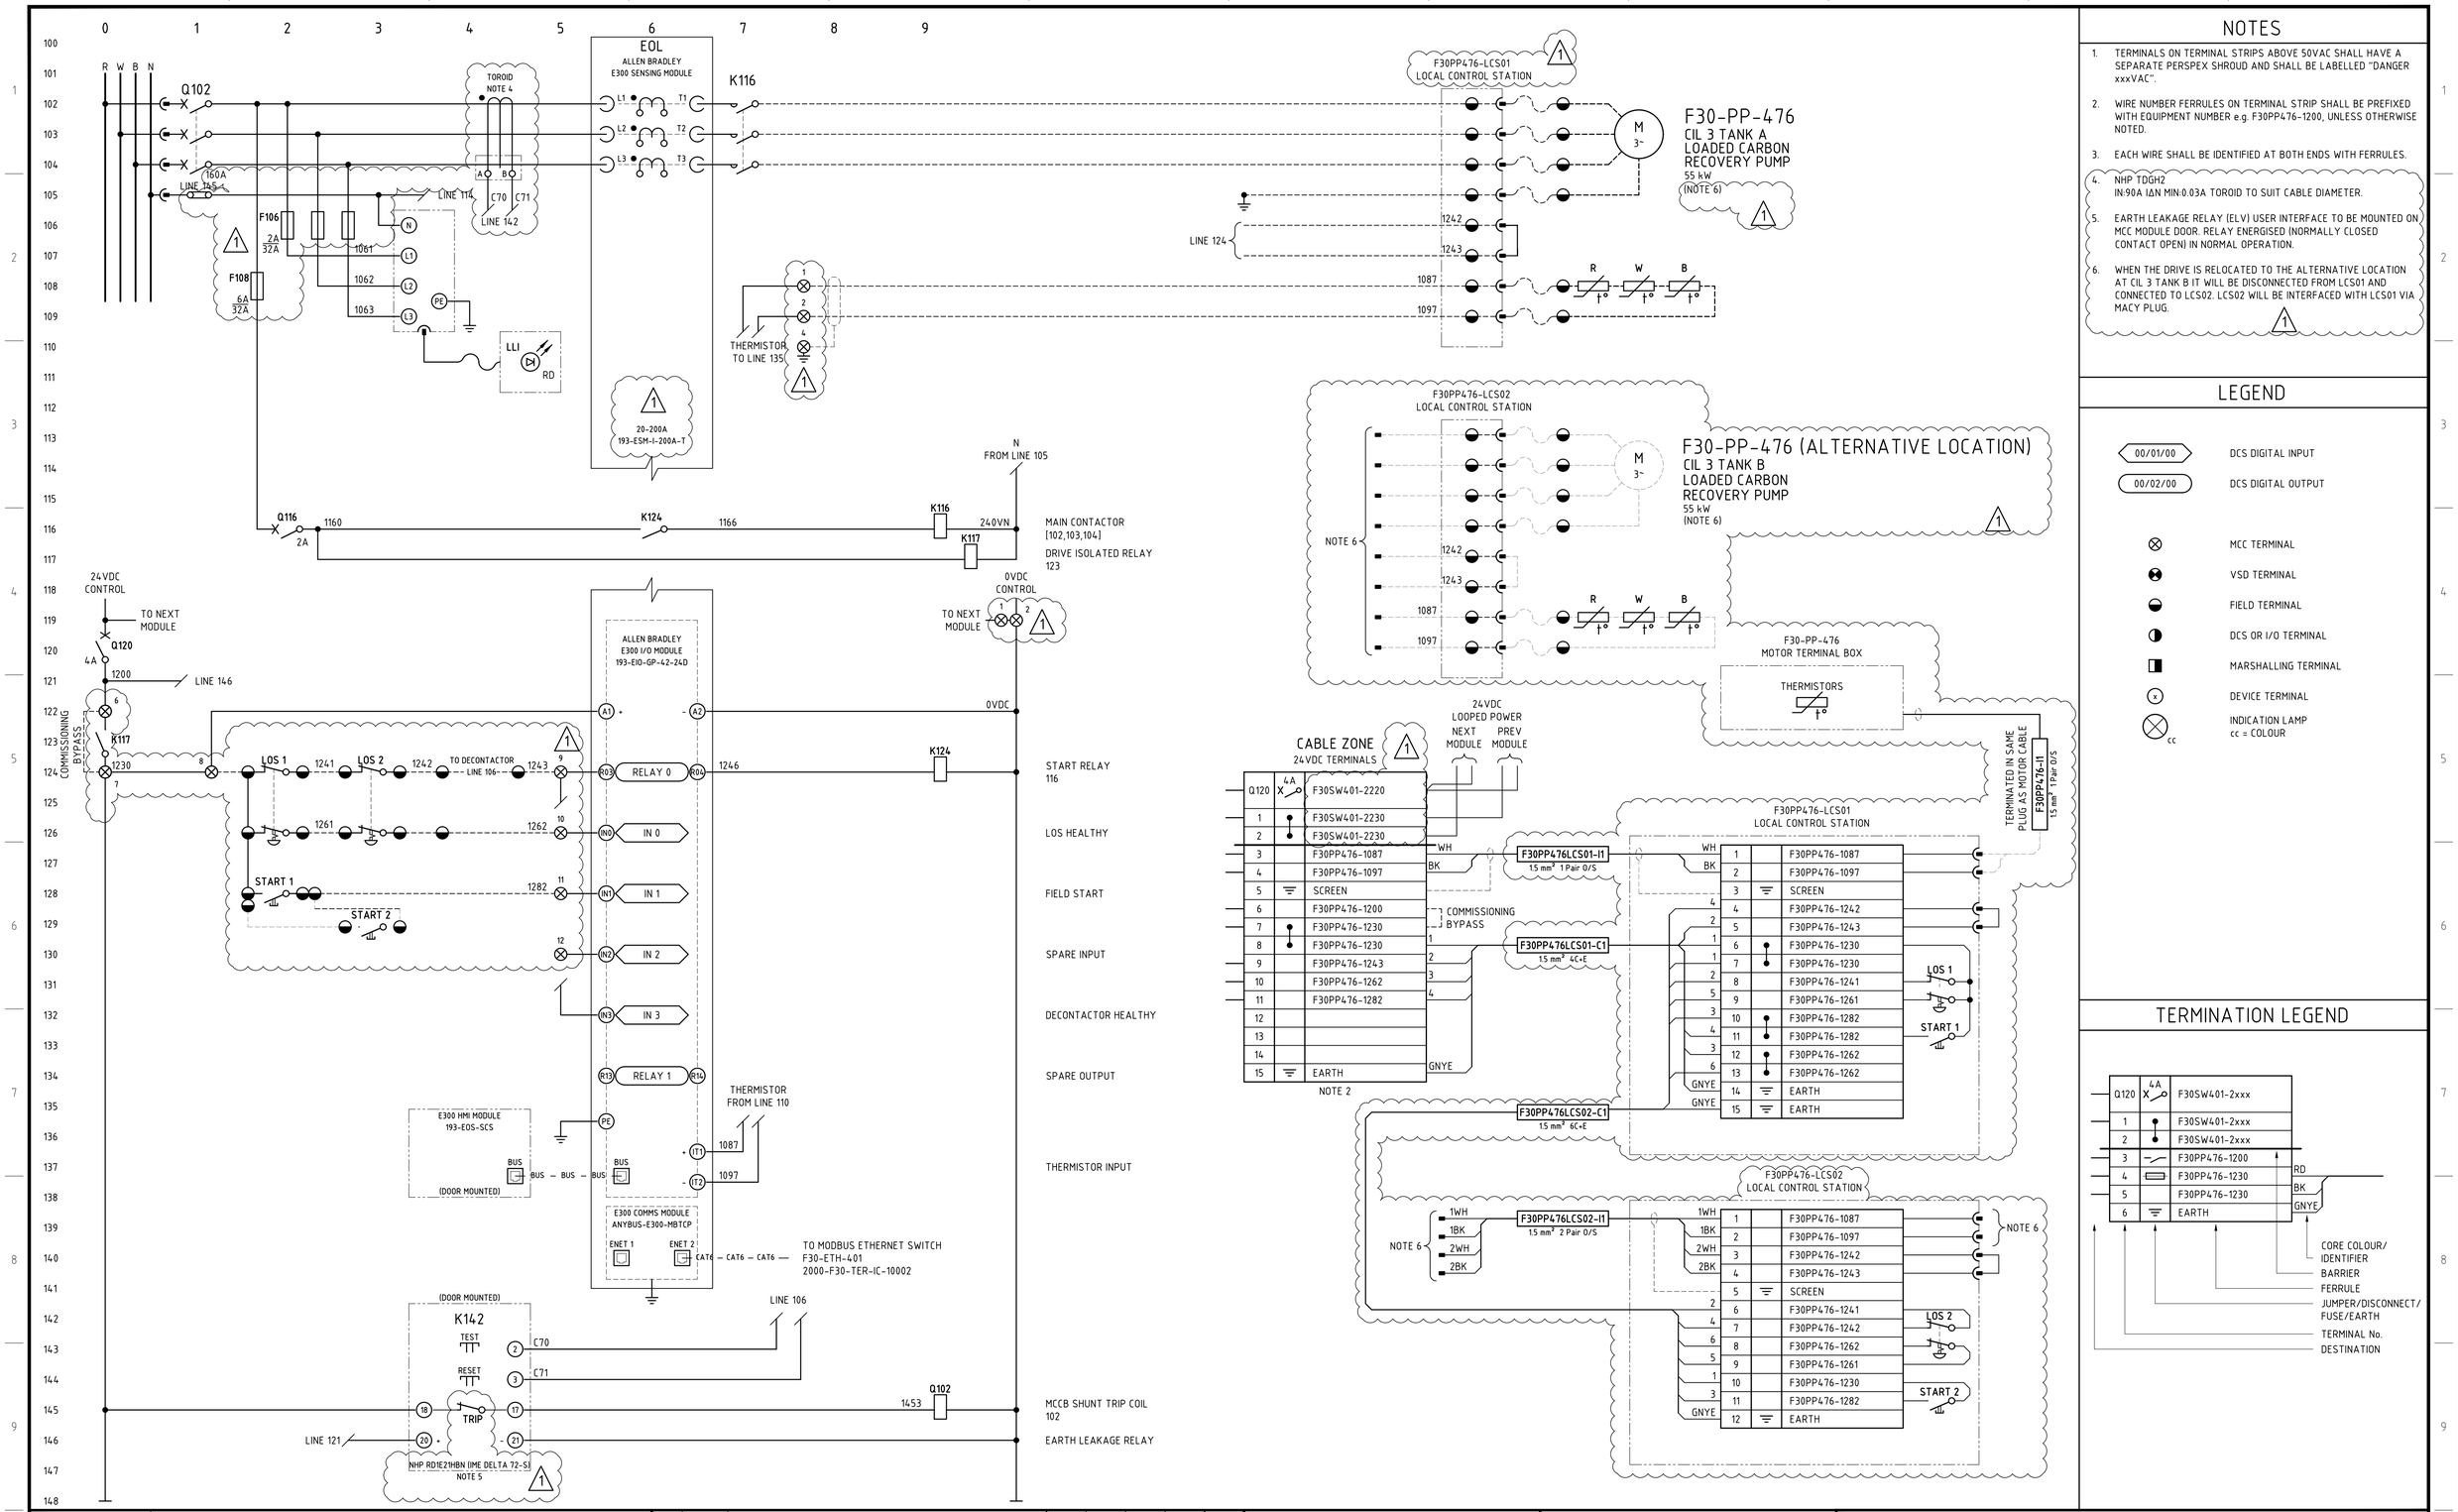


NOTES

1. TERMINALS ON TERMINAL STRIPS ABOVE 50VAC SHALL HAVE A SEPARATE PERSPEX SHROUD AND SHALL BE LABELLED "DANGER xxxVAC".
2. WIRE NUMBER FERRULES ON TERMINAL STRIP SHALL BE PREFIXED WITH EQUIPMENT NUMBER e.g. F30PP476-1200, UNLESS OTHERWISE NOTED.
3. EACH WIRE SHALL BE IDENTIFIED AT BOTH ENDS WITH FERRULES.
4. NHP TDGH2
   IN:90A IΔN MIN:0.03A TOROID TO SUIT CABLE DIAMETER.
5. EARTH LEAKAGE RELAY (ELV) USER INTERFACE TO BE MOUNTED ON MCC MODULE DOOR. RELAY ENERGISED (NORMALLY CLOSED CONTACT OPEN) IN NORMAL OPERATION.
6. WHEN THE DRIVE IS RELOCATED TO THE ALTERNATIVE LOCATION AT CIL 3 TANK B IT WILL BE DISCONNECTED FROM LCS01 AND CONNECTED TO LCS02. LCS02 WILL BE INTERFACED WITH LCS01 VIA MACY PLUG.

LEGEND

- 00/01/00 — DCS DIGITAL INPUT
- 00/02/00 — DCS DIGITAL OUTPUT
- MCC TERMINAL
- VSD TERMINAL
- FIELD TERMINAL
- DCS OR I/O TERMINAL
- MARSHALLING TERMINAL
- DEVICE TERMINAL
- INDICATION LAMP
  cc = COLOUR

TERMINATION LEGEND

DRG No.	REFERENCES
2000-F30-SCM-EL-10034	415V MCC F30-SW-401 24VDC DISTRIBUTION SCHEMATIC DIAGRAM
2000-F30-SLD-EL-10301	SUBSTATION NO. 68 MCC F30-SW-401 SINGLE LINE DIAGRAM SHEET 1
2000-F00-STD-EL-10001	GENERAL NOTES AND STANDARD DRAWING INDEX

REV	DATE	DESCRIPTION	DRAW	CHECK	DESIGN	TECH APP	PROJ APP
1	24OCT25	FAT REDLINES AND ALTERNATIVE LCS LOCATION INCORPORATED					
0	07APR25	APPROVED FOR CONSTRUCTION					

NORTHERN STAR RESOURCES LIMITED

PRIMERO
primero.com.au | DESIGN | CONSTRUCT | OPERATE

PRIMERO PROJECT NUMBER: 23517

INFORMATION AND REPRESENTATIONS ON THIS DRAWING ARE THE INTELLECTUAL PROPERTY OF PRIMERO UNLESS SPECIFICALLY IDENTIFIED OTHERWISE. ALL RIGHTS INCLUDING USE RESERVED

PROJECT: NORTHERN STAR RESOURCES LTD
KCGM GROWTH PROJECT

TITLE: FIMISTON PLANT - SUBSTATION NO. 68 MCC F30-SW-401
F30-PP-476 CIL3 TANK A LOADED CARBON PUMP
SCHEMATIC AND TERMINATION DIAGRAM

SHEET	SCALE	DRG No.	REVISION
A1	NONE	2000-F30-SCM-EL-10029	1

O:\CAD PROJECTS\23S NORTHERN STAR RESOURCES LTD\23517 KCGM GROWTH PROJECT\03 DELIVERABLES\ELV\F30 - CIL2_3 & CONCENTRATE THICKENING\2000-F30-SCM-EL-10029.DWG 24OCT25 8:13AM HOTSEAT04