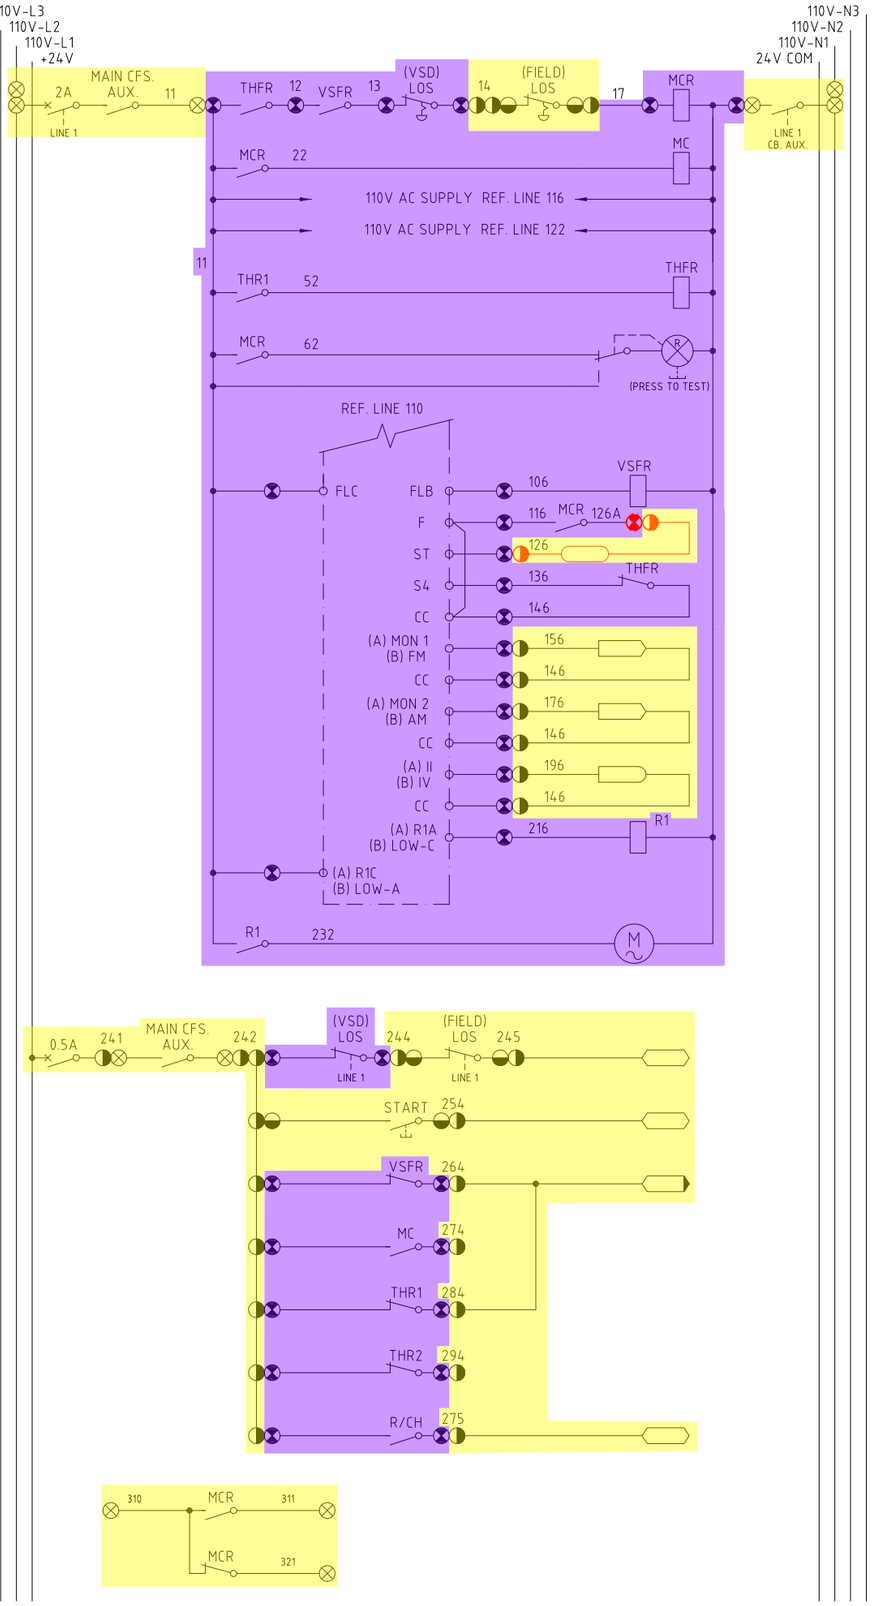


START RELAY

MAIN CONTACTOR RELAY

MAIN CONTACTOR

TO THERMISTOR RELAY 1 (TRIP)

TO THERMISTOR RELAY 2 (ALARM)

THERMISTOR FAULT RELAY

VSD SUPPLY AVAILABLE

VSD FAULT RELAY

MAIN CONTACTOR RELAY

DRIVE START OUTPUT

THERMISTOR FAULT RELAY

REMOTE SPEED INPUT

REMOTE CURRENT INPUT

REMOTE SPEED OUTPUT

COOLING FAN RELAY

COOLING FAN


STOP INPUT

START INPUT

VSD FAULT INPUT

RUN INPUT

POWER LAYOUT

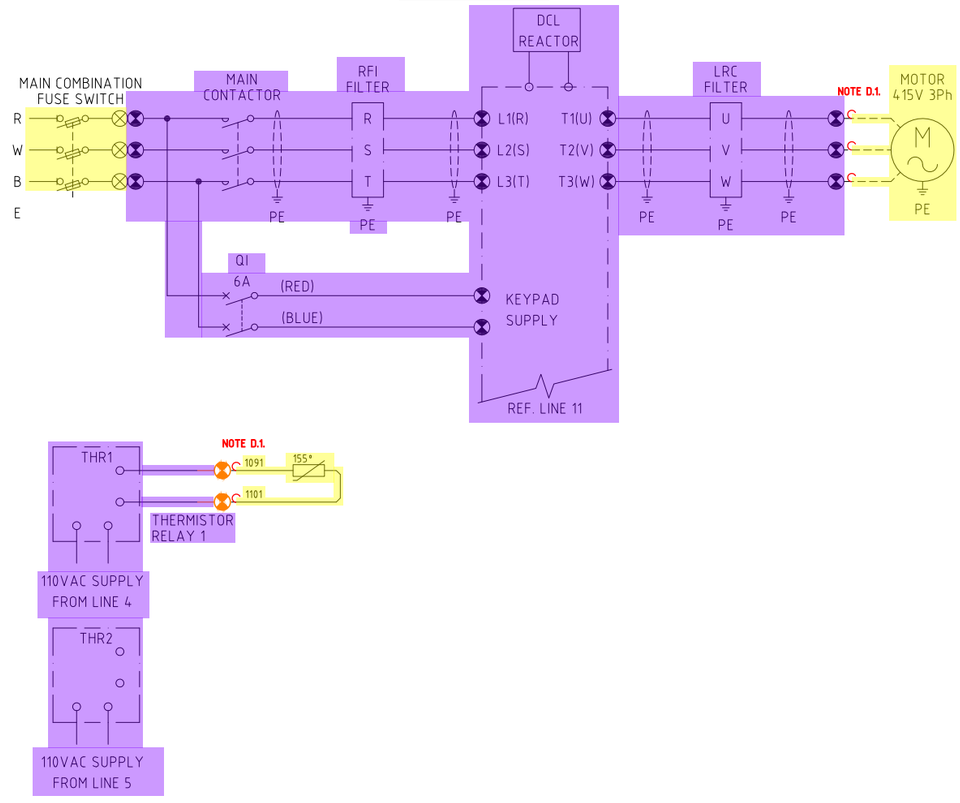

EQUIPMENT NUMBER	DESCRIPTION	MODULE NUMBER	FERRULE PREFIX		DCS START OUTPUT	DCS STOP INPUT	DCS START INPUT	DCS VSD FAULT INPUT
SPARE 30-PP-61A	FLOTATION TAILS THICKENER 3 U/FLOW PUMP "A"	3F/1	PP61A		%Z055225	%Z053414	%Z053415	%Z053416
SPARE 30-PP-61B	FLOTATION TAILS THICKENER 3 U/FLOW PUMP "B"	3F/2	PP61B		%Z055229	%Z054105	%Z054106	%Z054107

EQUIPMENT NUMBER	DCS RUN INPUT	DCS REM SPEED ANALOG OUTPUT	DCS MTR AMPS ANALOG INPUT	VSD UNIT NUMBER	DB NUMBER	PANEL NUMBER	24V C/B NUMBER		
SPARE 30-PP-61A	%Z054108	2000-F30-SCM-IC-10470	2000-F30-SCM-IC-10470	30VS61A	30PC62	DF	1/8		
SPARE 30-PP-61B	%Z054108	2000-F30-SCM-IC-10470	2000-F30-SCM-IC-10470	30VS61B	30PC62	DF	1/9		

LEGEND
- EXISTING
- NON-EXISTENT
- STAGE 1 - NEW
- STAGE 1 - REMOVE
- STAGE 1 - DECOMMISSIONED (OTHERS)
- STAGE 2 - NEW
- STAGE 2 - REMOVE
- STAGE 2 - DECOMMISSIONED (OTHERS)

KCGM GROWTH PROJECT DEMOLITION NOTES

D.1. VSD OUTGOING FIELD CABLES CABLES TO BE DISCONNECTED AND MADE SAFE AT BOTH ENDS.

KCGM GROWTH PROJECT

DRAWING NO. 2000-F30-SCM-EL-10052

REV	DATE	DESCRIPTION	CHECK	TECH APP
0	10/11/25	APPROVED FOR CONSTRUCTION	[redacted]	

LEGEND

TERMINALS
- MOTOR CONTROL CENTRE (MCC)
- FIELD
- PROCESS CONTROL CUBICLE
- LINE CONDITIONER
- SOFT STARTER TERMINAL
- VARIABLE SPEED DRIVE
- DISTRIBUTION BOARD
- HV MOTOR CONTROL CENTRE
- MISC. ELECTRICAL DEVICE REFER NOTES FOR SPECIFIC DESC.

DIGITAL FUNCTIONS
- DCS INPUT
- DCS INPUT WITH ALARM FUNCTION
- DCS OUTPUT

ANALOGUE FUNCTION
- 4-20mA INPUT
- 4-20mA OUTPUT

ANCILLARY EQUIPMENT
- CIRCUIT BREAKER
- COMBINATION FUSE SWITCH
- ISOLATOR
- PUSH BUTTON
- LOS (LOCK OFF STOP)
- PULL WIRE SWITCH
- NORMALLY CLOSED CONTACT
- LIMIT SWITCH
- CONTACTOR CONTACT
- NORMALLY OPEN CONTACT
- TIMER CONTACT
- FUNCTION CONTACT
  - P - PRESSURE
  - T° - TEMPERATURE
  - F - FLOW
  - L - FLOAT
- SIREN
- HORN
- RELAY
- LINK
- THERMISTOR
- INDICATION LAMP (R - RED, G - GREEN, A - AMBER)

VOLTAGES ON CONTROL BUS
- +24V - 24V DC DCS SUPPLY BUS
- 110V-L1 - 110V AC MCC CONTROL BUS
- 110V-L2 - 110V AC CONDITIONED BUS
- 110V-L3 - 110V AC NON CONDITIONED BUS

NOTES

1. ALL WIRES EXCEPT CONTROL SUPPLIES & THOSE WITHIN FORM 4 MODULES SHALL BE FERRULED WITH PREFIX LISTED IN ABOVE TABLE.

MK	DATE	REVISION	BY	CKD	APP
1	24-10-03	AS BUILT	[redacted]		

REFERENCE DRAWINGS

DWG NO.

PROJ. FILE #.

SCALE	NTS
DRAWN	[redacted] 24-10-03
DESIGNED	
CHECKED	
APPROVED	
PROJ.APP	

FIMISTON PLANT
FLOTATION AREA TAILS THICKENER
FLOTATION TAILS THICKENER 3 U/FLOW [redacted] A&B
CONTROL SCHEMATIC

SIZE	DRAWING NUMBER	REV
A1	30/E/0449	1

KALGOORLIE CONSOLIDATED GOLD MINES PTY. LTD. ACN 009 377 619