
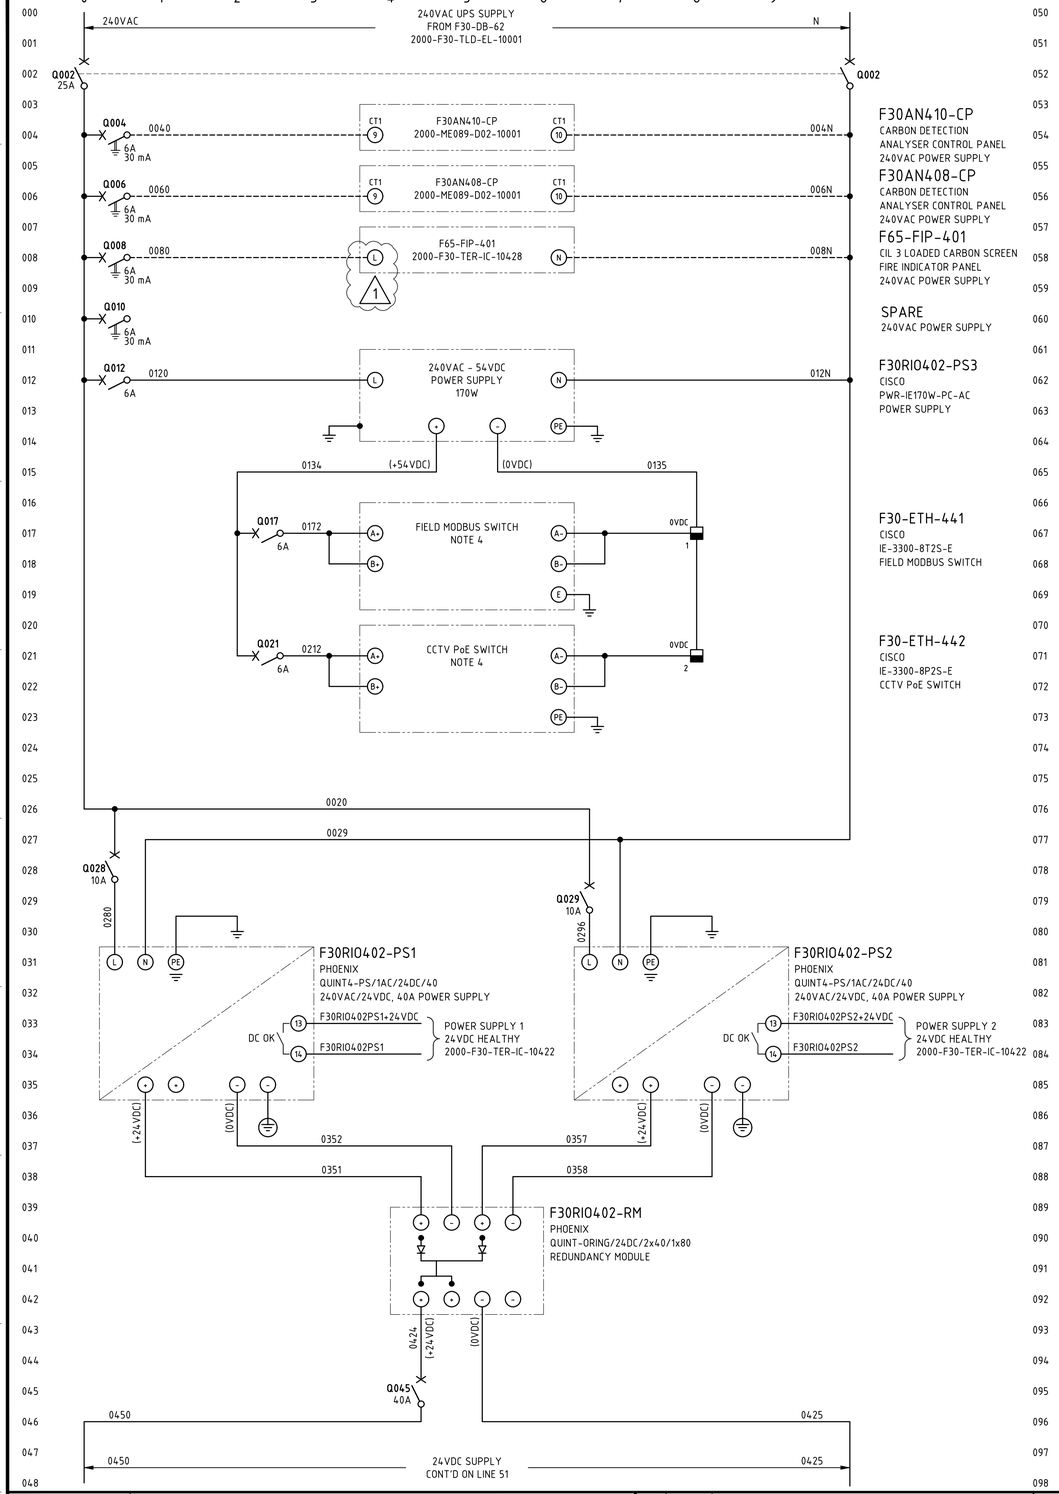


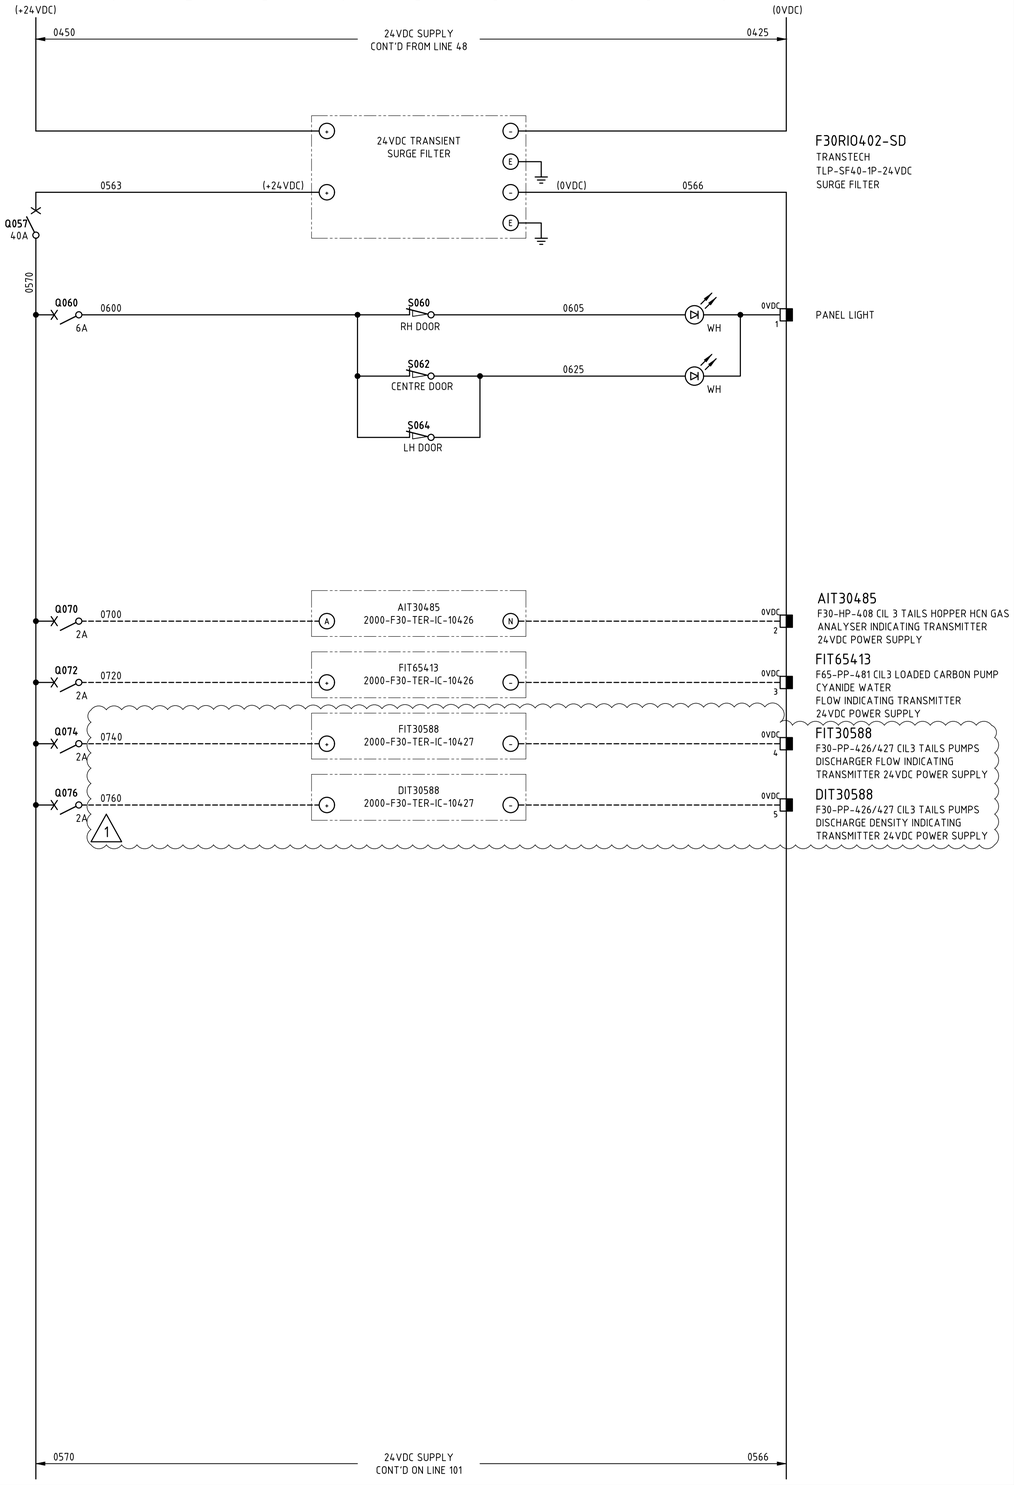

NOTES

1. TERMINALS ON TERMINAL STRIPS ABOVE 50VAC SHALL HAVE A SEPARATE PERSPEX SHROUD AND SHALL BE LABELLED "DANGER xxxVAC".
2. WIRE NUMBER FERRULES ON TERMINAL STRIP SHALL BE PREFIXED WITH EQUIPMENT NUMBER e.g. F30RIO402-xxxx.
3. EACH WIRE SHALL BE IDENTIFIED AT BOTH ENDS WITH FERRULES.
4. FOR NETWORK CONNECTION & BUS CABLING DETAILS REFER TO RIO PANEL COMMUNICATIONS TERMINATION DIAGRAMS.
5. INSTRUMENT EARTH BAR TO BE BONDED TO MAIN EARTH BAR WITH SOLID COPPER LINK.

LEGEND

- FIELD TERMINAL
- DCS OR I/O TERMINAL
- 0VDC TERMINAL FOR 24VDC
- 0VDC TERMINAL FOR 54VDC
- DEVICE TERMINAL
- INDICATION LAMP (cc = COLOUR)
- EARTH BAR
- INSTRUMENT EARTH BAR

DRG No.	REFERENCES
2000-F30-TLD-EL-10001	240V INSTRUMENT DISTRIBUTION BOARD NO. 62 POWER SCHEMATIC
2000-F30-DRG-IC-10421	F30-RIO-402 FIELD N-IO PANEL GENERAL ARRANGEMENT
2000-F30-SCM-IC-10422	F30-RIO-402 FIELD N-IO PANEL SCHEMATIC DIAGRAM SHEET 2
2000-F30-TER-IC-10420	F30-RIO-402 FIELD N-IO PANEL COMMUNICATIONS TERMINATION DIAGRAMS SHEET 1 (TO SHEET 2 - 10421)
2000-F30-TER-IC-10422	F30-RIO-402 FIELD N-IO PANEL TERMINATION DIAGRAMS SHEET 1 (TO SHEET 12 - 10433)
2000-F00-STD-EL-10001	GENERAL NOTES AND STANDARD DRAWINGS INDEX

REV	DATE	DESCRIPTION	DRAW	CHECK	DESIGN	TECH APP	PROJ APP
1	06NOV25	FAT REDLINES INCORPORATED					
0	09MAY25	APPROVED FOR CONSTRUCTION					

NORTHERN STAR RESOURCES LIMITED

PRIMERO
primero.com.au | DESIGN | CONSTRUCT | OPERATE

PRIMERO PROJECT NUMBER: 23517

INFORMATION AND REPRESENTATIONS ON THIS DRAWING ARE THE INTELLECTUAL PROPERTY OF PRIMERO UNLESS SPECIFICALLY IDENTIFIED OTHERWISE. ALL RIGHTS INCLUDING USE RESERVED

PROJECT: NORTHERN STAR RESOURCES LTD
KCGM GROWTH PROJECT

TITLE: FIMISTON PLANT - CARBON IN LEACH (CIL 3)
F30-RIO-402 CONC LEACH & ADSORPTION FIELD N-IO PANEL
SCHEMATIC DIAGRAM SHEET 1

SHEET	SCALE	DRG No.	REVISION
A1	NONE	2000-F30-SCM-IC-10421	1

O:\CAD PROJECTS\235 NORTHERN STAR RESOURCES LTD\23517 KCGM GROWTH PROJECT\03 DELIVERABLES\IC\F30 - CIL2_3 & CONCENTRATE THICKENING\2000-F30-SCM-IC-10421.DWG 19NOV25 11:46AM HOTSEAT04