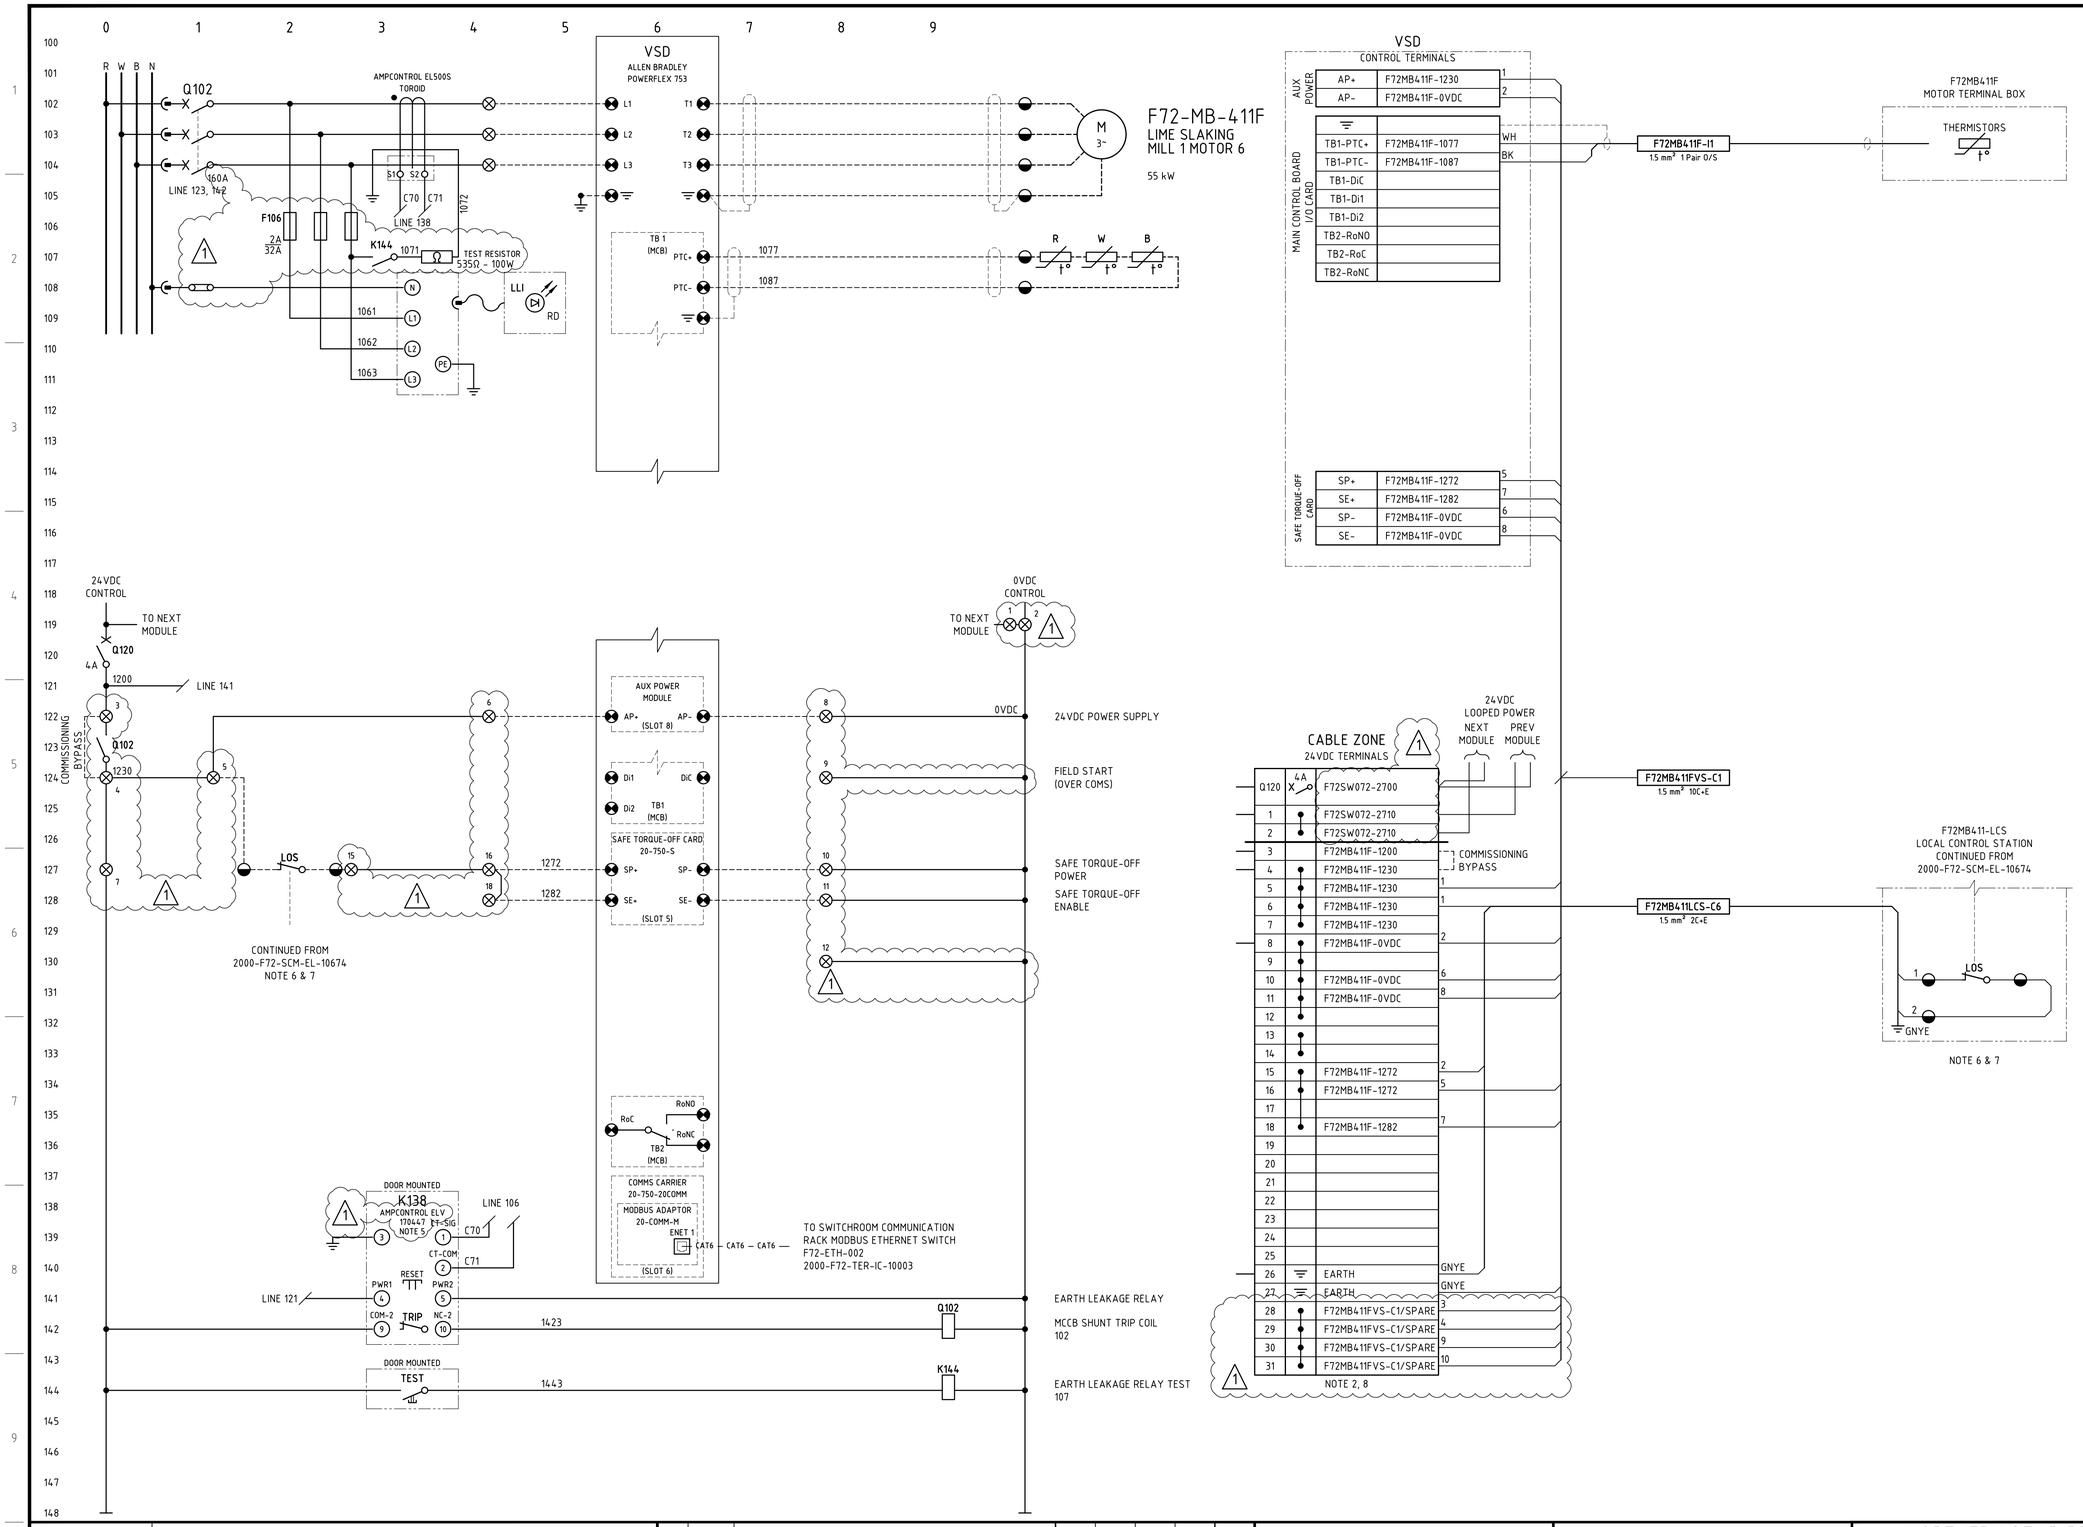


NOTES


1. TERMINALS ON TERMINAL STRIPS ABOVE 50VAC SHALL HAVE A SEPARATE PERSPEX SHROUD AND SHALL BE LABELLED "DANGER xxxVAC".
2. WIRE NUMBER FERRULES ON TERMINAL STRIP SHALL BE PREFIXED WITH EQUIPMENT NUMBER e.g. F72MB411F-1200, UNLESS OTHERWISE NOTED.
3. EACH WIRE SHALL BE IDENTIFIED AT BOTH ENDS WITH FERRULES.
4. AMPCONTROL 10164.9 100/1A TOROID. (1)
5. EARTH LEAKAGE RELAY (ELV) USER INTERFACE TO BE MOUNTED ON MCC MODULE DOOR. RELAY ENERGISED (NORMALLY CLOSED CONTACT OPEN) IN NORMAL OPERATION.
6. COMMON FIELD START BUTTON FOR LIME SLAKING MILL 1 MOTORS WIRED TO MILL 1 MOTOR 1 VSD DIGITAL INPUT. DCS WILL PERFORM SIMULTANEOUS START OF ALL 6 MILL MOTOR DRIVES VIA MODBUS COMMS.
7. COMMON E-STOP BUTTON WITH 6 OFF CONTACTS. ONE CONTACT WILL BE USED FOR EACH LIME SLAKING MILL MOTOR'S STO CIRCUIT.
8. SPARE CORES ARE TERMINATED AND EARTHED. (1)

LEGEND

- 00/01/00 — DCS DIGITAL INPUT
- 00/02/00 — DCS DIGITAL OUTPUT
- MCC TERMINAL
- VSD TERMINAL
- FIELD TERMINAL
- DCS OR I/O TERMINAL
- MARSHALLING TERMINAL
- DEVICE TERMINAL
- INDICATION LAMP (cc = COLOUR)

(1)

TERMINATION LEGEND

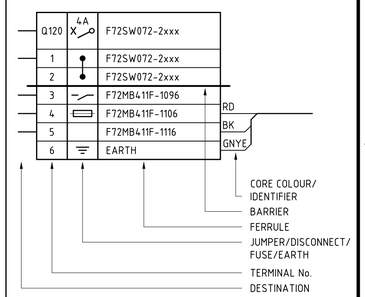

DRG No.	REFERENCES
2000-F72-TER-IC-10003	F72-COM-001 415 SWITCHROOM COMMUNICATIONS RACK TERMINATION DIAGRAM
2000-F72-SLD-EL-10201	F72-SW-072 415V MCC SINGLE LINE DIAGRAM SHEET 1
2000-F00-STD-EL-10001	GENERAL NOTES AND STANDARD DRAWINGS INDEX

REV	DATE	DESCRIPTION	DRAW	CHECK	DESIGN	TECH APP	PROJ APP
1	04NOV25	FAT REDLINES INCORPORATED					
0	14MAR25	APPROVED FOR CONSTRUCTION					

NORTHERN STAR RESOURCES LIMITED

PRIMERO
primero.com.au | DESIGN | CONSTRUCT | OPERATE

PRIMERO PROJECT NUMBER: 23517

INFORMATION AND REPRESENTATIONS ON THIS DRAWING ARE THE INTELLECTUAL PROPERTY OF PRIMERO UNLESS SPECIFICALLY IDENTIFIED OTHERWISE. ALL RIGHTS INCLUDING USE RESERVED

PROJECT: NORTHERN STAR RESOURCES LTD
KCGM GROWTH PROJECT

TITLE: REAGENTS MIXING & STORAGE - F72-SW-072
F72-MB-411F LIME SLAKING MILL 1 MOTOR 6
SCHEMATIC AND TERMINATION DIAGRAM

SHEET	SCALE	DRG No.	REVISION
A1	NONE	2000-F72-SCM-EL-10675	1

O:\CAD PROJECTS\235 NORTHERN STAR RESOURCES LTD\23517 KCGM GROWTH PROJECT\03 DELIVERABLES\EL\F72 - REAGENTS MIXING & STORAGE\2000-F72-SCM-EL-10675.DWG 02DEC25 12:41PM HOTSEAT04