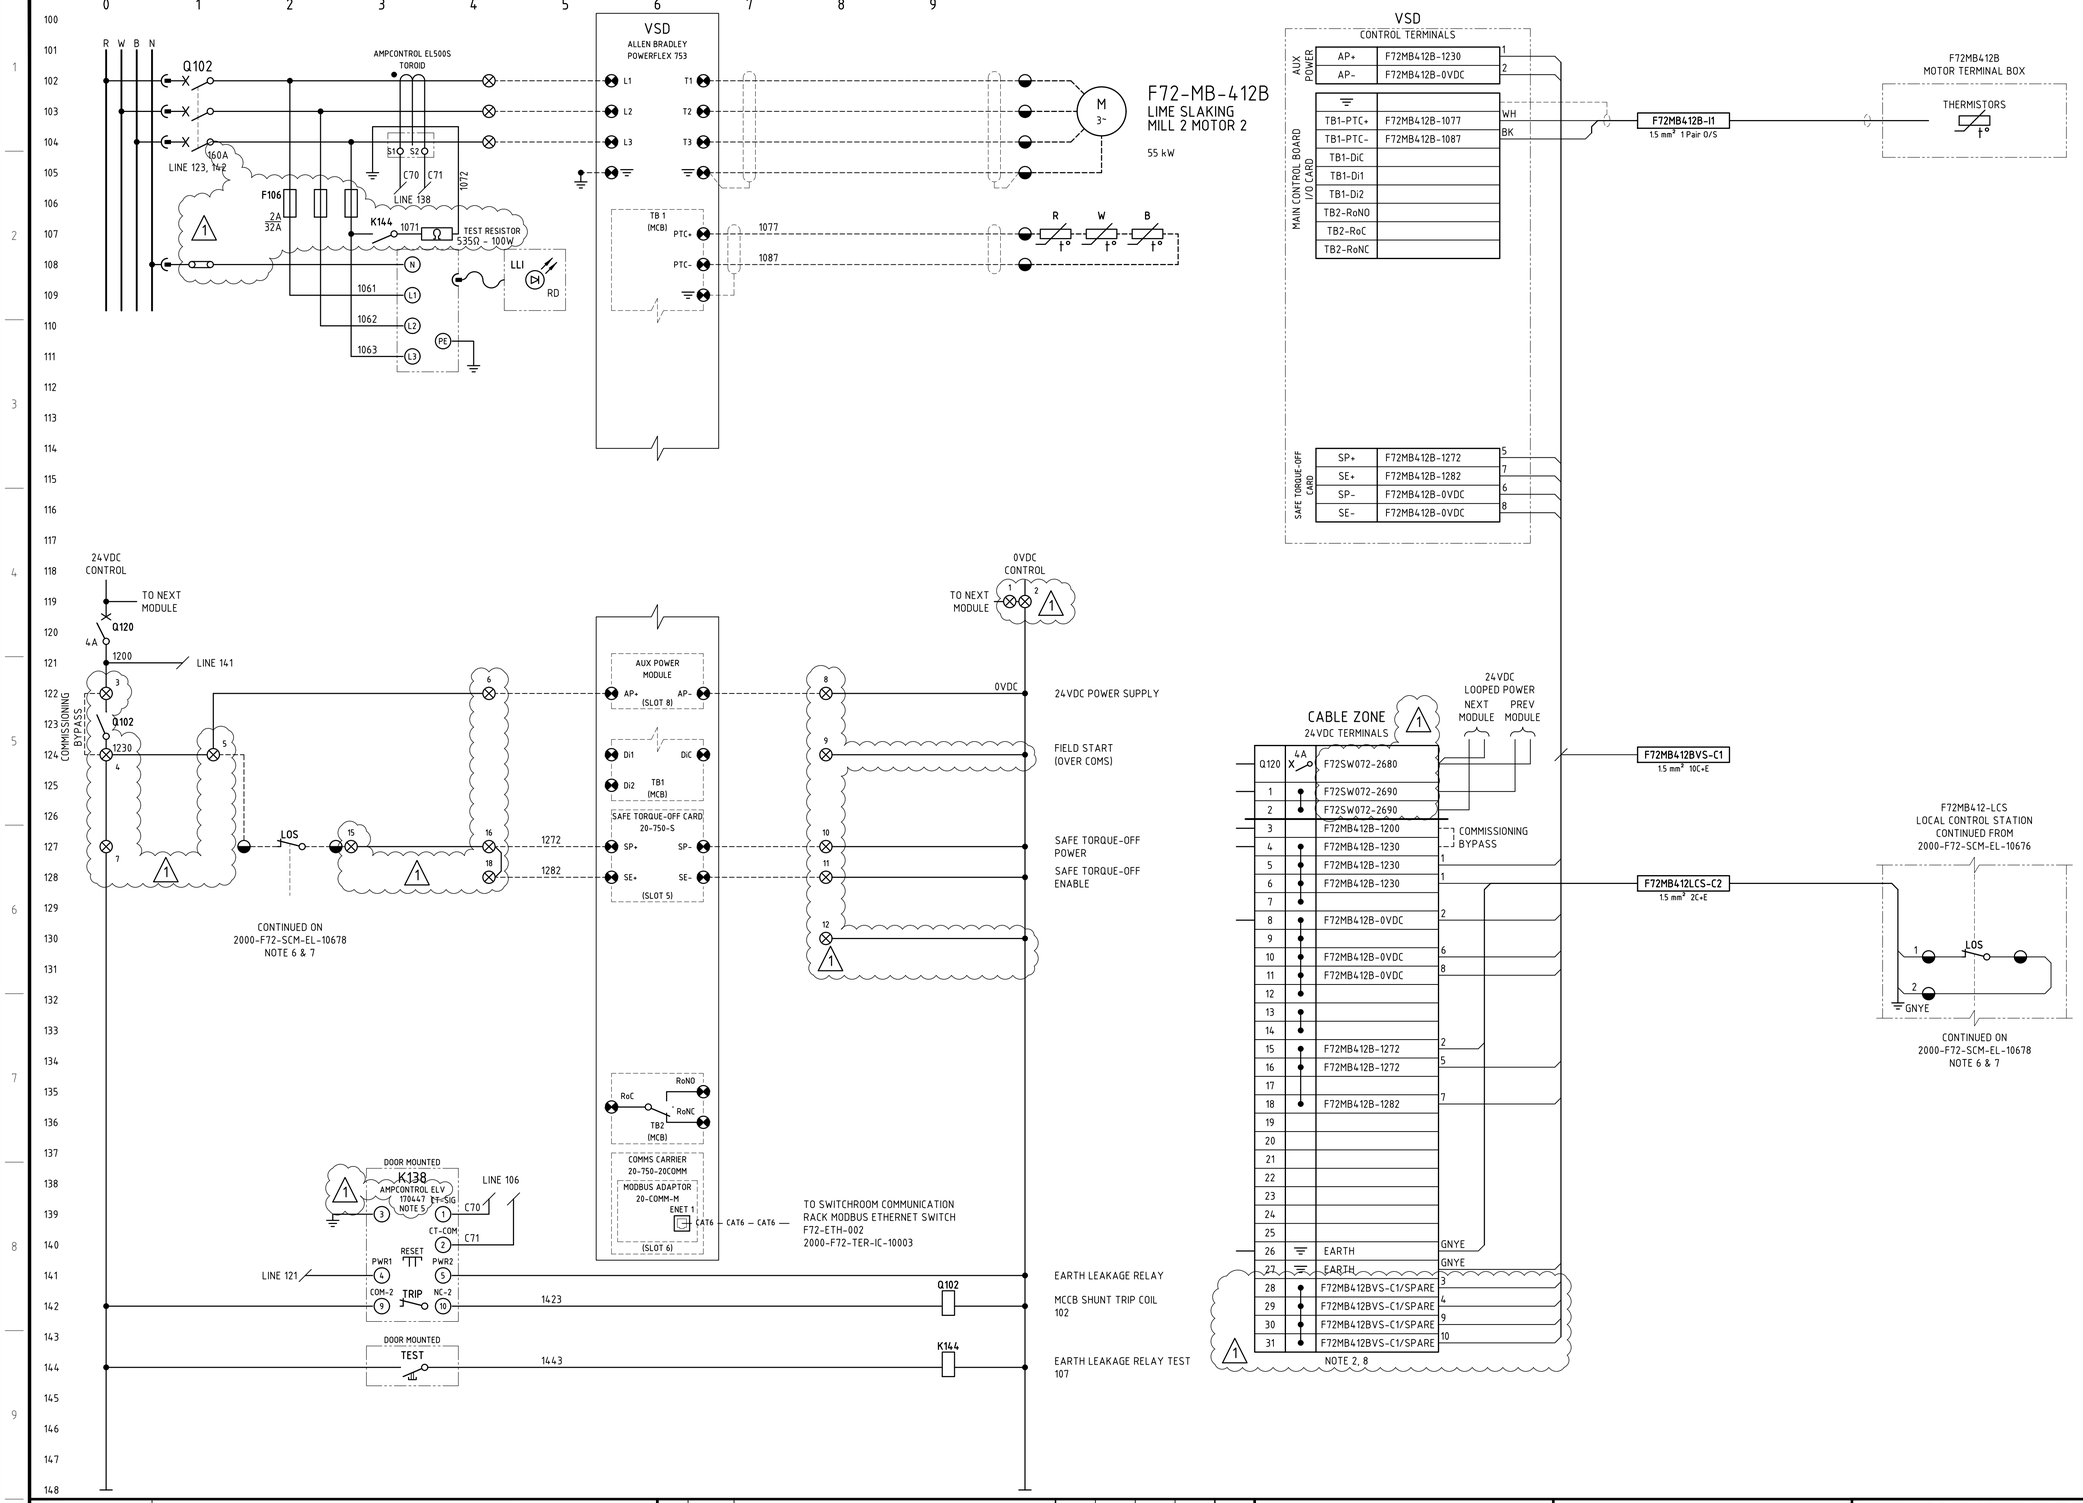



## NOTES


1. TERMINALS ON TERMINAL STRIPS ABOVE 50VAC SHALL HAVE A SEPARATE PERSPEX SHROUD AND SHALL BE LABELLED "DANGER xxxVAC".
2. WIRE NUMBER FERRULES ON TERMINAL STRIP SHALL BE PREFIXED WITH EQUIPMENT NUMBER e.g. F72MB412B-1200, UNLESS OTHERWISE NOTED.
3. EACH WIRE SHALL BE IDENTIFIED AT BOTH ENDS WITH FERRULES.
4. AMPCONTROL 101649 100/1A TOROID. (1)
5. EARTH LEAKAGE RELAY (ELV) USER INTERFACE TO BE MOUNTED ON MCC MODULE DOOR. RELAY ENERGISED (NORMALLY CLOSED CONTACT OPEN) IN NORMAL OPERATION.
6. COMMON FIELD START BUTTON FOR LIME SLAKING MILL 2 MOTORS WIRED TO MILL 2 MOTOR 1 VSD DIGITAL INPUT. DCS WILL PERFORM SIMULTANEOUS START OF ALL 6 MILL MOTOR DRIVES VIA MODBUS COMMS.
7. COMMON E-STOP BUTTON WITH 6 OFF CONTACTS. ONE CONTACT WILL BE USED FOR EACH LIME SLAKING MILL MOTOR'S STO CIRCUIT.
8. SPARE CORES ARE TERMINATED AND EARTHED. (1)

## LEGEND

- 00/01/00 — DCS DIGITAL INPUT
- 00/02/00 — DCS DIGITAL OUTPUT
- MCC TERMINAL
- VSD TERMINAL
- FIELD TERMINAL
- DCS OR I/O TERMINAL
- MARSHALLING TERMINAL
- DEVICE TERMINAL
- INDICATION LAMP (cc = COLOUR)

(1)

## TERMINATION LEGEND

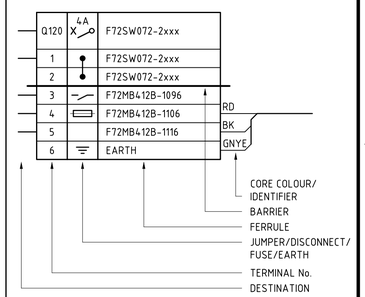


| DRG No. | REFERENCES |
|---|---|
| 2000-F72-TER-IC-10003 | F72-COM-001 415 SWITCHROOM COMMUNICATIONS RACK TERMINATION DIAGRAM |
| 2000-F72-SLD-EL-10201 | F72-SW-072 415V MCC SINGLE LINE DIAGRAM SHEET 1 |
| 2000-F00-STD-EL-10001 | GENERAL NOTES AND STANDARD DRAWINGS INDEX |

| REV | DATE | DESCRIPTION | DRAW | CHECK | DESIGN | TECH APP | PROJ APP |
|---|---|---|---|---|---|---|---|
| 1 | 04NOV25 | FAT REDLINES INCORPORATED | | | | | |
| 0 | 14MAR25 | APPROVED FOR CONSTRUCTION | | | | | |

NORTHERN STAR RESOURCES LIMITED

PRIMERO
primero.com.au | DESIGN | CONSTRUCT | OPERATE

PRIMERO PROJECT NUMBER: 23517

INFORMATION AND REPRESENTATIONS ON THIS DRAWING ARE THE INTELLECTUAL PROPERTY OF PRIMERO UNLESS SPECIFICALLY IDENTIFIED OTHERWISE. ALL RIGHTS INCLUDING USE RESERVED

PROJECT: NORTHERN STAR RESOURCES LTD
KCGM GROWTH PROJECT

TITLE: REAGENTS MIXING & STORAGE - F72-SW-072
F72-MB-412B LIME SLAKING MILL 2 MOTOR 2
SCHEMATIC AND TERMINATION DIAGRAM

| SHEET | SCALE | DRG No. | REVISION |
|---|---|---|---|
| A1 | NONE | 2000-F72-SCM-EL-10677 | 1 |

O:\CAD PROJECTS\235 NORTHERN STAR RESOURCES LTD\23517 KCGM GROWTH PROJECT\03 DELIVERABLES\EL\F72 - REAGENTS MIXING & STORAGE\2000-F72-SCM-EL-10677.DWG 02DEC25 12:41PM HOTSEAT04