
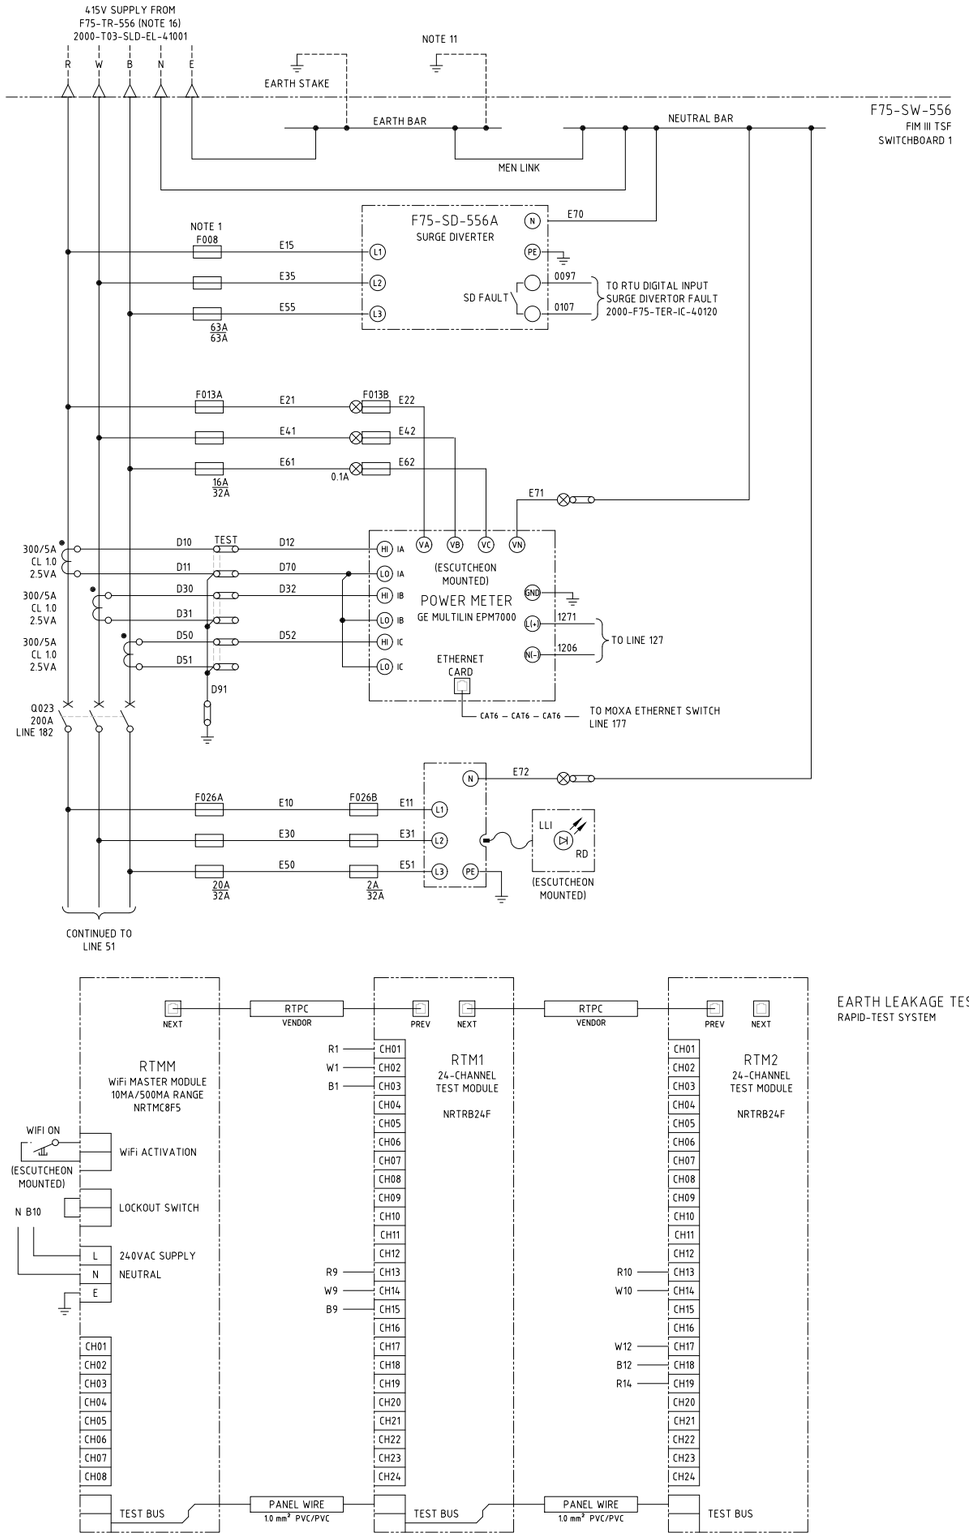


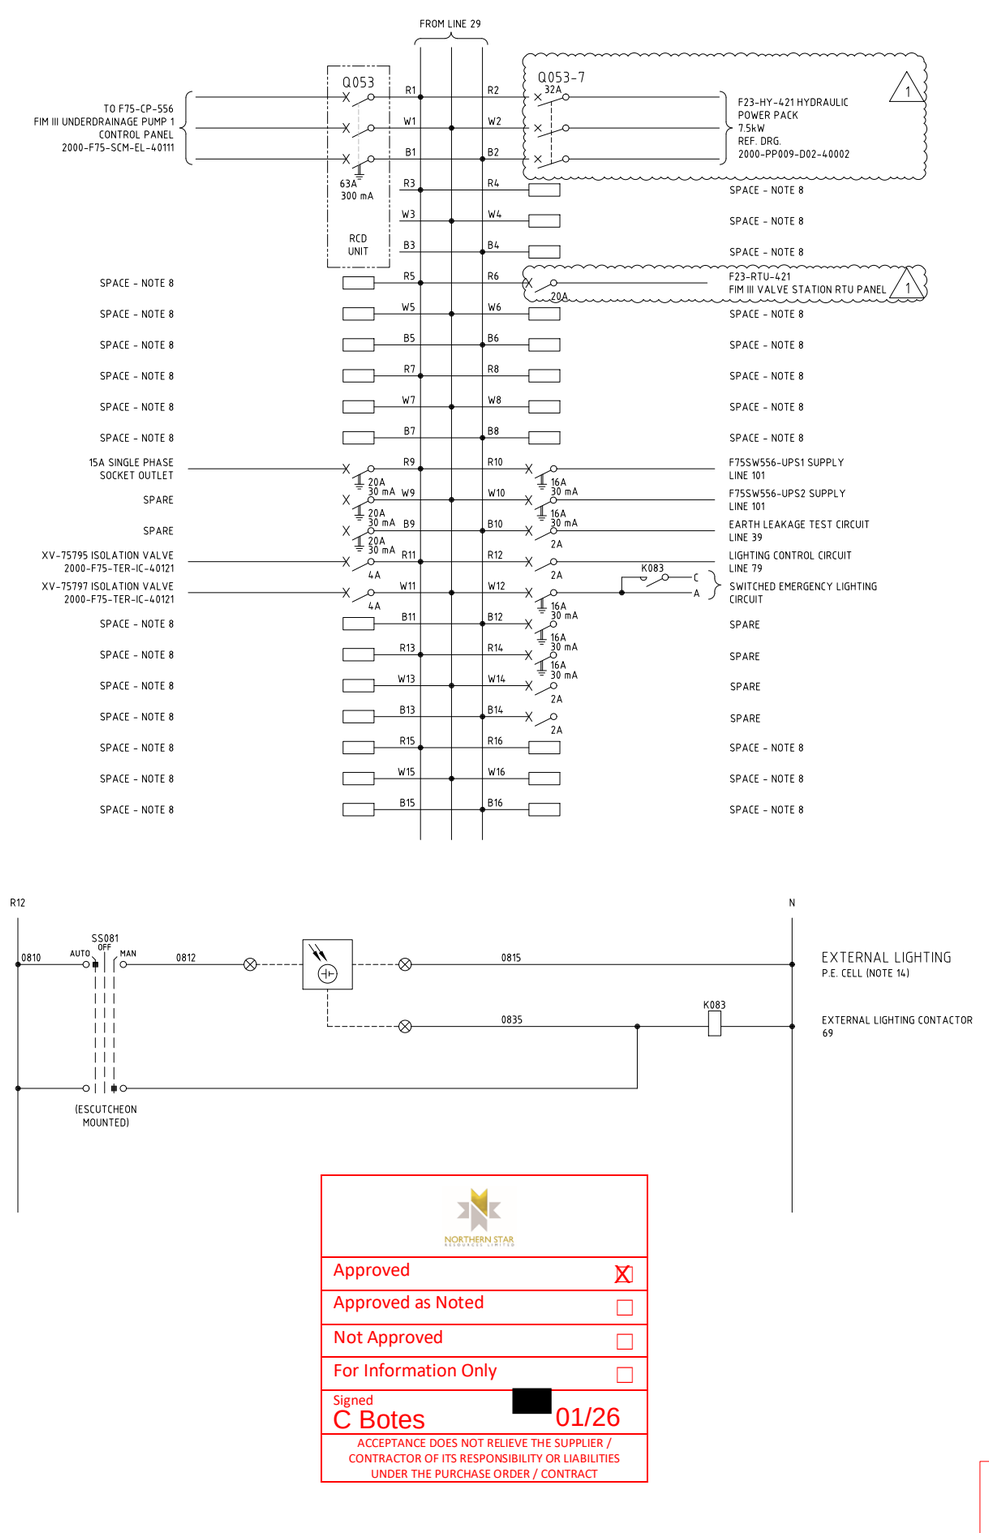

NOTES

1. SURGE DIVERTER FUSES SHALL BE SIZED BY VENDOR TO SUIT DUTY.
2. MINIATURE CIRCUIT BREAKERS SHALL BE SIZED AND RATED TO SUIT INCOMER REQUIREMENTS.
3. ALL TERMINATIONS ABOVE 50VAC SHALL BE TO IP2x OR ABOVE, IF NOT, TO HAVE A SEPARATE PERSPEX SHROUD FITTED AND SHALL BE LABELLED "DANGER xxxVAC".
4. WIRE NUMBER FERRULES ON TERMINAL STRIP SHALL BE PREFIXED WITH EQUIPMENT NUMBER e.g. F75SW556-XXXX, UNLESS NOTED OTHERWISE.
5. EACH WIRE SHALL BE IDENTIFIED AT BOTH ENDS WITH FERRULES.
6. THREE PHASE CIRCUITS SHALL ALWAYS BE PLACED ACROSS CIRCUIT RWB – i.e. R7, W7, B7 – NEVER ACROSS MIXED CIRCUITS i.e. B5, R7, W7.
7. CIRCUIT BREAKERS SHALL BE PAD-LOCKABLE IN THE 'OFF' POSITION ONLY, VIA LOCK-DOGS OR SIMILAR, LOCKING TO ESCUTCHEON SHALL NOT BE ACCEPTABLE.
8. ALL SPARE SPACE SHALL BE FILLED WITH DUMMY CIRCUIT BREAKERS, ESCUTCHEON POLE FILLERS SHALL NOT BE ACCEPTABLE.
9. ESCUTCHEON SHALL BE KEYED TO MAIN ISOLATOR HANDLE SUCH THAT ESCUTCHEON CANNOT BE REMOVED WHILE BOARD IS LIVE.
10. NEUTRAL CIRCUITS FED FROM RCDs MUST BE WIRED BACK TO THE NEUTRAL OF THE RCD, NOT THE NEUTRAL BAR.
11. EQUIPOTENTIAL BONDING CONDUCTOR SHALL BE INSTALLED FROM SWITCHBOARD EARTH BAR TO EQUIPMENT OUTLINED IN ELCTRICAL INSTALLATION SPEC 2000-F00-STS-EL-10012 VIA 35mm² Cu GNYE/PVC.
12. 6kA MINIATURE CIRCUIT BREAKERS SHALL ONLY BE USED WITH ENGINEERING APPROVAL.
13. AS-BUILT CIRCUIT SCHEDULE SHALL BE KEPT INTERNAL TO SWITCHBOARD AT ALL TIMES.
14. P.E. CELL SHALL BE INSTALLED OUT OF DIRECT LINE OF ANY LIGHTING.
15. EARTH-NEUTRAL LINK SHALL BE INSTALLED IN SWITCHBOARD. SIGNAGE SHALL BE PLACED ON SWITCHBOARD AND ON TRANSFORMER TO THAT EFFECT. LINK SHALL BE IDENTIFIED C/W LABEL STATING "M.E.N. LINK – DO NOT REMOVE".
16. SWITCHBOARD SUPPLY TO BE CONNECTED TO POLE MOUNTED FUSE SWITCH ON LV SIDE OF TRANSFORMER (SUPPLIED BY OTHERS).

LEGEND

- MxDIxx — RTU DIGITAL INPUT
- MxDOxx — RTU DIGITAL OUTPUT
- PE CELL
- SWITCHBOARD TERMINAL
- VSD TERMINAL
- FIELD TERMINAL
- DCS OR I/O TERMINAL
- RTU TERMINAL
- DEVICE TERMINAL
- INDICATION LAMP (cc = COLOUR)

NORTHERN STAR RESOURCES LIMITED

Approved	X
Approved as Noted	
Not Approved	
For Information Only	

Signed C Botes 01/26

ACCEPTANCE DOES NOT RELIEVE THE SUPPLIER / CONTRACTOR OF ITS RESPONSIBILITY OR LIABILITIES UNDER THE PURCHASE ORDER / CONTRACT

APPROVED FOR CONSTRUCTION

REFERENCES	DWG No	REV	DATE	REVISION	DRN	CHK	TECH APP	PROJ APP
F75-SW-556 FIM III TSF SWITCHBOARD 1 GENERAL ARRANGEMENT SHEET 1	2000-F75-DRG-EL-40111				ET (Initial)	MC (DS)	KV	TH
F75-SW-556 FIM III TSF SWITCHBOARD 1 SCHEMATIC DIAGRAM SHEET 2	2000-F75-SCM-EL-40119	1	15.DEC.25	RE-APPROVED FOR CONSTRUCTION	ET	MC	KV	TH
GENERAL NOTES AND STANDARD DRAWINGS INDEX	2000-F00-STD-EL-10001	0	29.MAY.25	APPROVED FOR CONSTRUCTION	TG	KVN	KVN	TH

NORTHERN STAR RESOURCES LIMITED

DRA PACIFIC (PTY) LIMITED

DRAWN	J.TORRALBA	15.MAY.2025
CHECKED	J.Y.WEE	15.MAY.2025
DESIGNED	J.TORRALBA	15.MAY.2025
TECH APP	K.VAN NAMEN	27.MAY.2025
PROJ APP	T.HAMDORF	29.MAY.2025
CLIENT APP		

PROJECT: KCGM
FIM TSF PROJECT

TITLE: FIM III TAILINGS DAM
F75-SW-556 FIM III TSF SWITCHBOARD 1
SCHEMATIC DIAGRAM SHEET 1

A1 | SCALE NTS | DRG No. 2000-F75-SCM-EL-40118 | REV 1