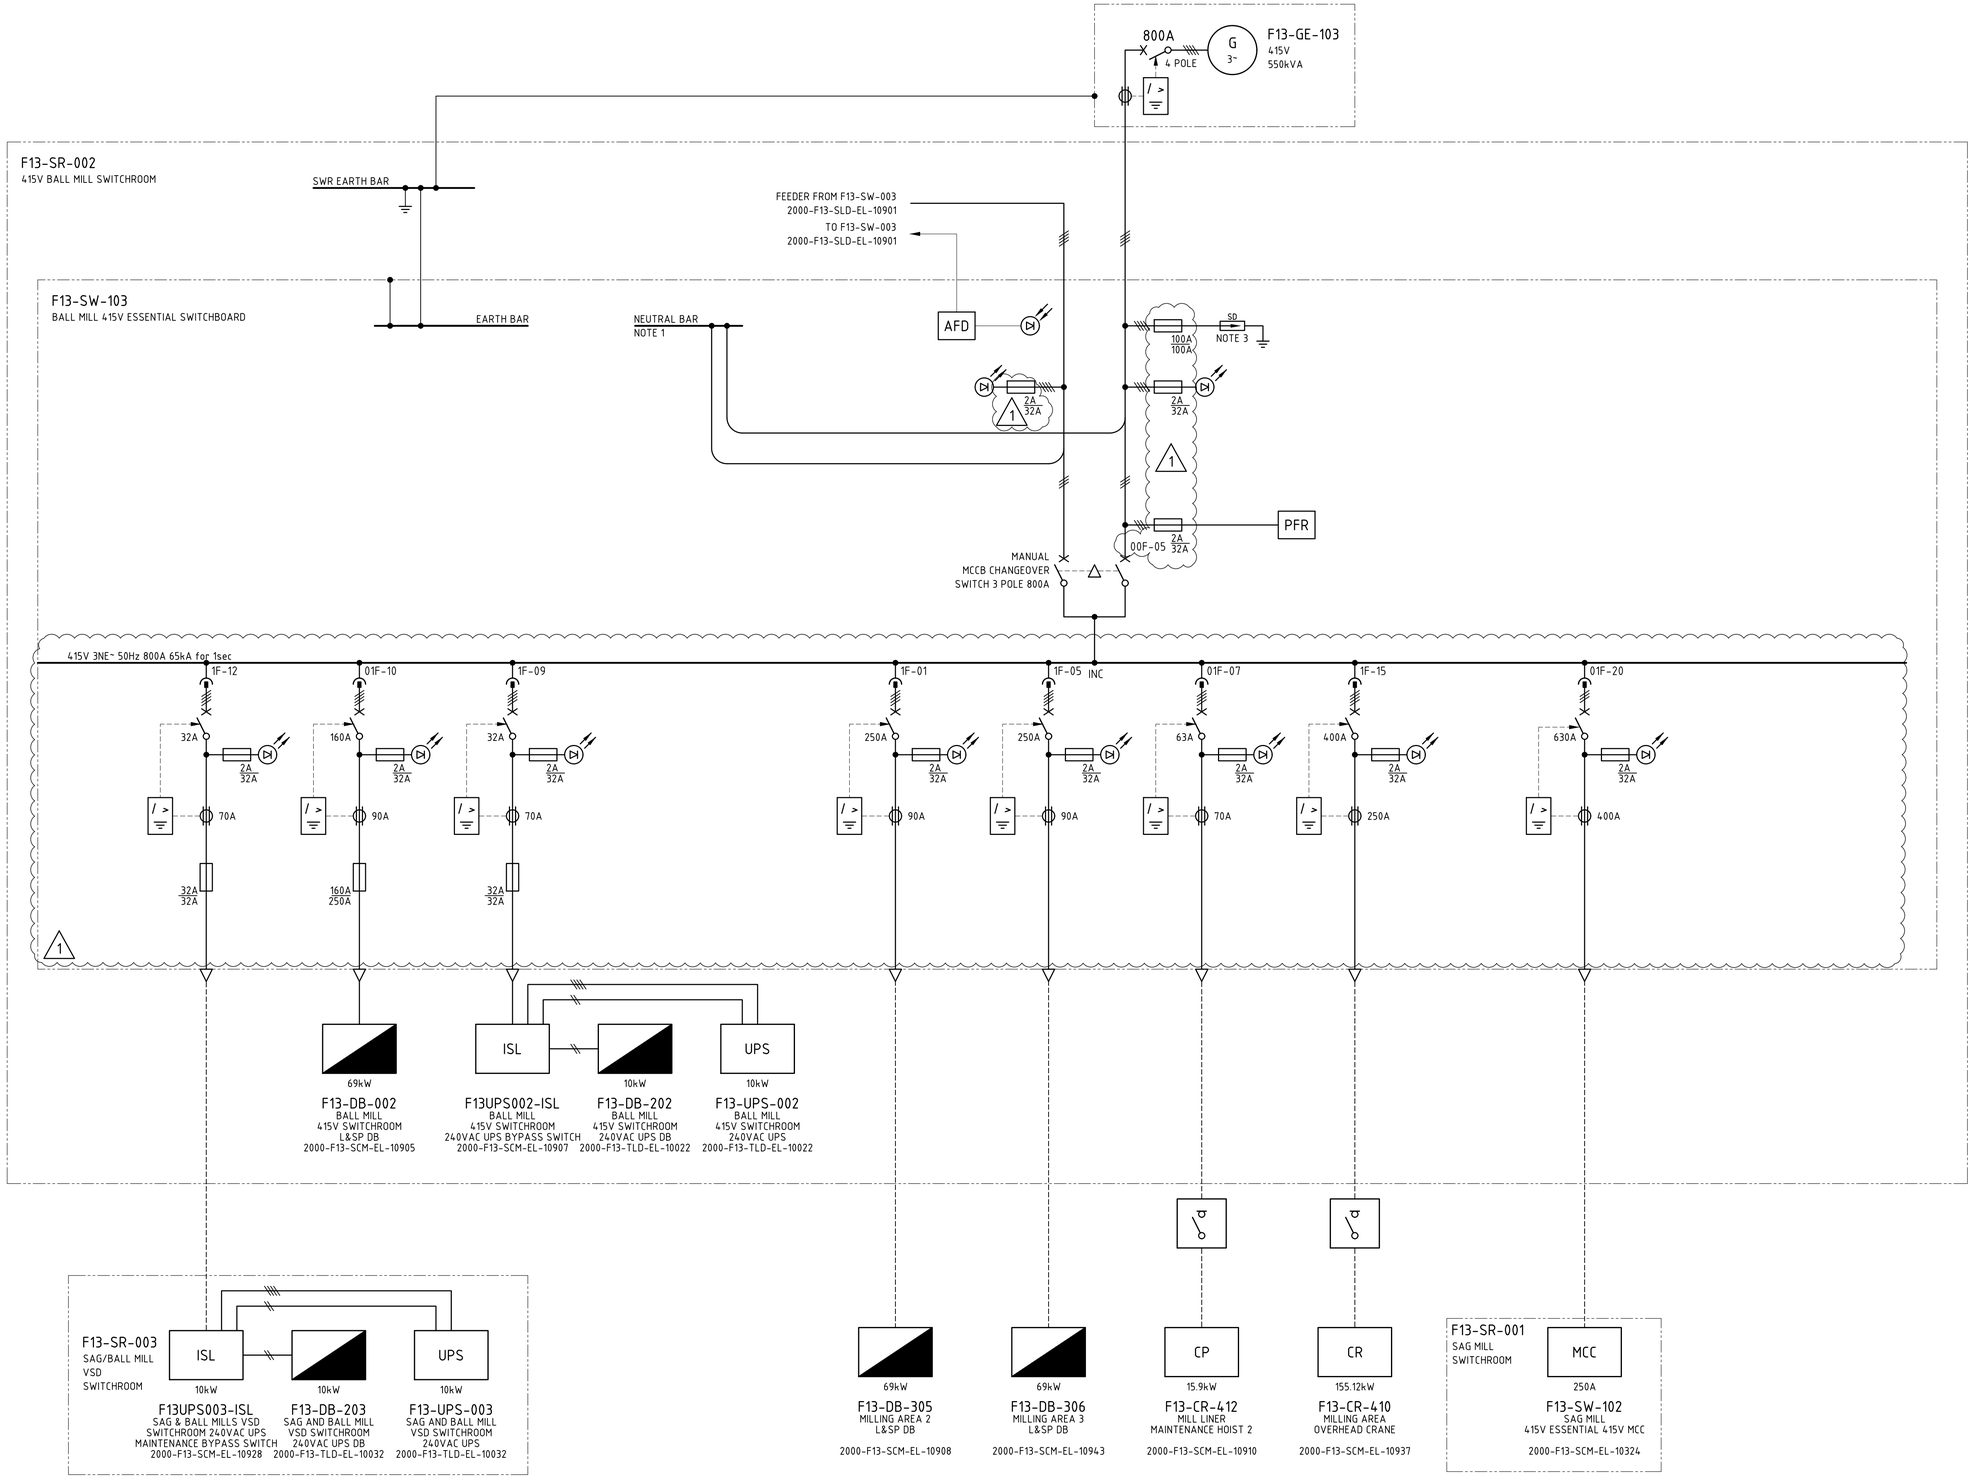


NOTES

1. EARTH-NEUTRAL LINK INSTALLED IN UPSTREAM F13-SW-003 INCOMER TIER. SIGNAGE SHALL BE PLACED ON F13-SW-103 SWITCHBOARD AND ON GENERATOR READING "M.E.N. LINK LOCATED IN F13-SW-003 INCOMER TIER"
2. SWITCHBOARD SHALL BE EXTENSIBLE AND BE PROVIDED WITH THE FACILITY TO EXTEND THE MAIN BUSBAR AND APPEND ADDITIONAL TIERS AT ONE END WITHOUT MAJOR STRUCTURAL DISASSEMBLY.
3. SURGE DIVERTERS SHALL PROVIDE FEEDBACK TO DCS VIA VOLT-FREE CONTACTS. SURGE DIVERTER FUSES SHALL BE SIZED BY VENDOR TO SUIT DUTY.
4. MINIATURE CIRCUIT BREAKERS SHALL BE SIZED AND RATED TO SUIT ACB AND INCOMER REQUIREMENTS.
5. CIRCUIT BREAKER TO BE SUBSTITUTED FOR FUSED-SWITCH WHERE REQUIRED BY EQUIPMENT MANUFACTURERS GUIDELINES.

LEGEND

PFR	PHASE FAILURE RELAY
/ >	EARTH LEAKAGE RELAY
xxxA / xxxA	ST TRIP SET POINT / CB SIZE
AFD	ARC FLASH DETECTION
ECR	EARTH CONTINUITY RELAY

NORTHERN STAR RESOURCES LIMITED

Approved	X
Approved as Noted	
Not Approved	
For Information Only	

Signed [redacted] Date 09/10/2025

ACCEPTANCE DOES NOT RELIEVE THE SUPPLIER / CONTRACTOR OF ITS RESPONSIBILITY OR LIABILITIES UNDER THE PURCHASE ORDER / CONTRACT

DRG No.	REFERENCES
2000-F13-SCM-EL-10904	F13-SW-003 415V MCC ARC FLASH SYSTEM SCHEMATIC DIAGRAM
2000-F13-SCM-EL-10903	F13-SW-003 415V MCC 24VDC DISTRIBUTION SCHEMATIC DIAGRAM
2000-F13-SCM-EL-10953	F13-SW-103 415V ESSENTIAL SWITCHBOARD INCOMER SCHEMATIC DIAGRAM
2000-F13-DRG-EL-10102	F13-SR-002 415V SWITCHROOM ELECTRICAL EQUIPMENT LAYOUT
2000-F13-BLK-IC-10001	F13-SR-002 415V SWITCHROOM AND REMOTE I/O COMMUNICATIONS BLOCK DIAGRAM
2000-F13-SLD-EL-10901	F13-SW-901 415V MCC SINGLE LINE DIAGRAM SHEET 1
2000-F00-SLD-EL-10002	F00-SW-010 33kV SWITCHBOARD SINGLE LINE DIAGRAM SHEET 1 OF 5
2000-F00-STD-EL-10001	GENERAL NOTES AND STANDARD DRAWINGS INDEX

REV	DATE	DESCRIPTION	DRAW	CHECK	DESIGN	TECH APP	PROJ APP
1	02SEP25	FAT REDLINES INCORPORATED					
0	29AUG24	APPROVED FOR CONSTRUCTION					

NORTHERN STAR RESOURCES LIMITED

PRIMERO
primero.com.au | DESIGN | CONSTRUCT | OPERATE

PRIMERO PROJECT NUMBER: 23517

INFORMATION AND REPRESENTATIONS ON THIS DRAWING ARE THE INTELLECTUAL PROPERTY OF PRIMERO UNLESS SPECIFICALLY IDENTIFIED OTHERWISE. ALL RIGHTS INCLUDING USE RESERVED

PROJECT: NORTHERN STAR RESOURCES LTD
KCGM GROWTH PROJECT

TITLE: MILLING & CLASSIFICATION - BALL MILL
F13-SW-103 415V ESSENTIAL SWITCHBOARD
SINGLE LINE DIAGRAM

SHEET	SCALE	DRG No.	REVISION
A1	NONE	2000-F13-SLD-EL-10911	1

O:\CAD PROJECTS\23517 NORTHERN STAR RESOURCES LTD\23517 KCGM GROWTH PROJECT\03 DELIVERABLES\ELF13 - MILLING & CLASSIFICATION\2000-F13-SLD-EL-10911.DWG 25SEP25 12:53PM HOTSEAT04