
F16-SR-002
415V FLOTATION SWITCHROOM

F16-SW-004
FLOTATION 415V MOTOR CONTROL CENTRE

CONTINUED ON SHT 1
2000-F16-SLD-EL-10201

CONTINUED ON SHT 3
2000-F16-SLD-EL-10203

415V 3NE~ 50Hz 4000A 65kA for 1sec

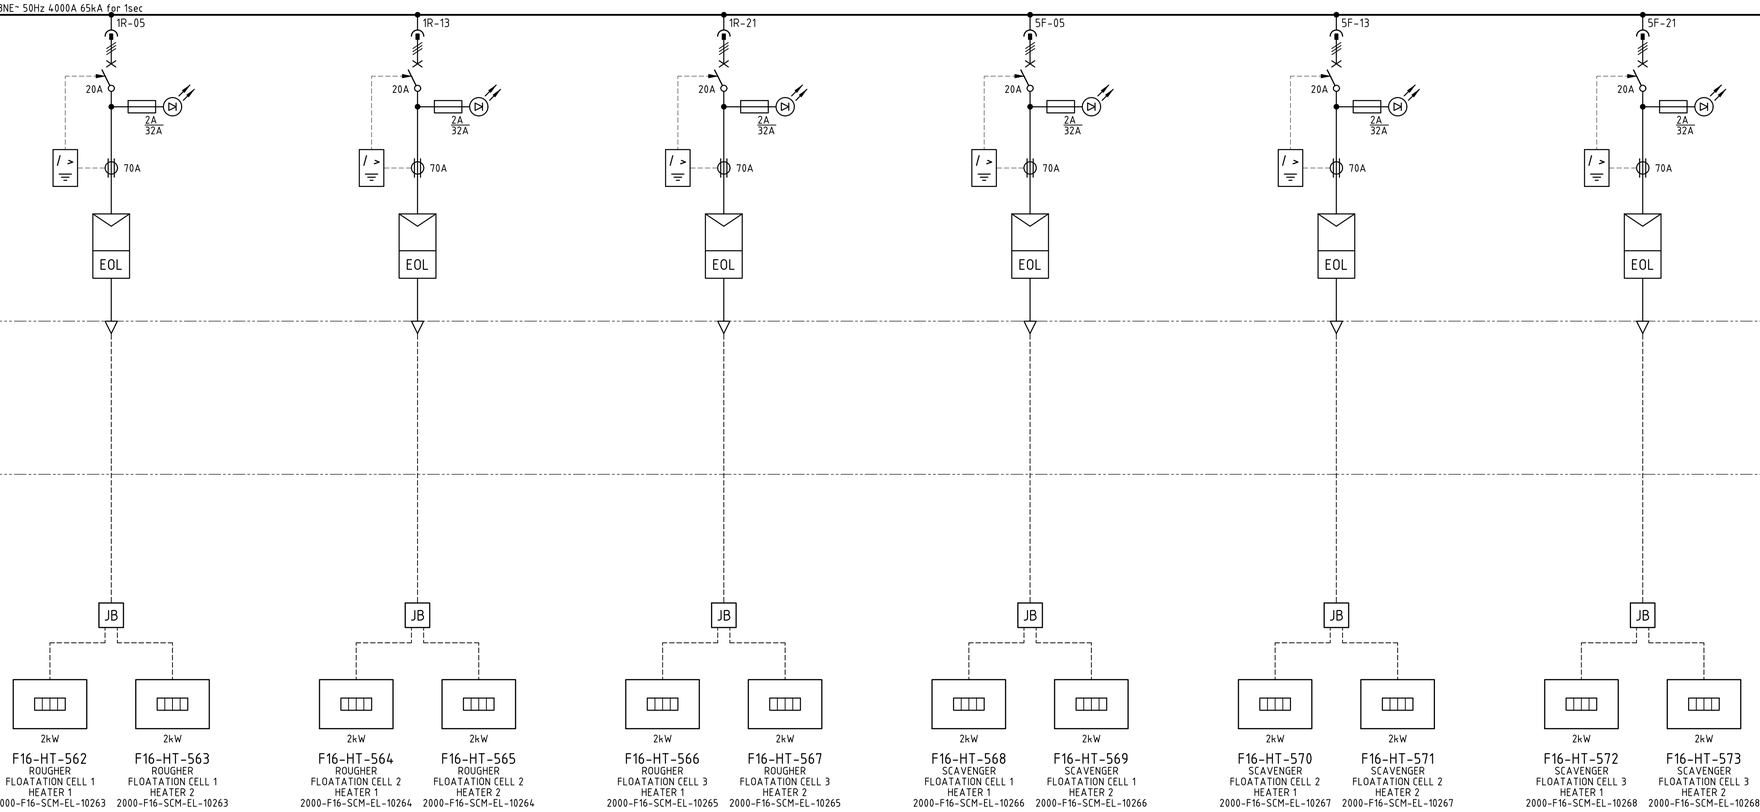

NOTES

1. REFER TO SHEET 1.

LEGEND

1. REFER TO SHEET 1.

DRG No.	REFERENCES
2000-F16-SCM-EL-10223	F16-SW-004 415V MCC ARC FLASH SYSTEM SCHEMATIC DIAGRAM
2000-F16-SCM-EL-10222	F16-SW-004 415V MCC 24VDC DISTRIBUTION SCHEMATIC DIAGRAM
2000-F16-SCM-EL-10221	F16-SW-004 415V MCC INCOMER SCHEMATIC DIAGRAM
2000-F16-DRG-EL-10101	F16-SR-002 415V SWITCHROOM ELECTRICAL EQUIPMENT LAYOUT
2000-F16-BLK-IC-10001	F16-SR-002 415V SWITCHROOM AND REMOTE I/O COMMUNICATIONS BLOCK DIAGRAM
2000-F16-SLD-EL-10201	F16-SW-004 415V MCC SINGLE LINE DIAGRAM SHEET 1
2000-F00-SLD-EL-10002	F00-SW-010 33kV SWITCHBOARD SINGLE LINE DIAGRAM SHEET 1 OF 5
2000-F00-STD-EL-10001	GENERAL NOTES AND STANDARD DRAWINGS INDEX

REV	DATE	DESCRIPTION	DRAW	CHECK	DESIGN	TECH APP	PROJ APP
2	07SEP26	KCGM GROWTH PROJECT - SP1 AS-BUILT					
1	26AUG25	FAT REDLINES INCORPORATED					
0	11JUN24	APPROVED FOR CONSTRUCTION					

NORTHERN STAR RESOURCES LIMITED

PRIMERO
primero.com.au | DESIGN | CONSTRUCT | OPERATE

PRIMERO PROJECT NUMBER: 23517

INFORMATION AND REPRESENTATIONS ON THIS DRAWING ARE THE INTELLECTUAL PROPERTY OF PRIMERO UNLESS SPECIFICALLY IDENTIFIED OTHERWISE. ALL RIGHTS INCLUDING USE RESERVED

PROJECT: NORTHERN STAR RESOURCES LTD
KCGM GROWTH PROJECT

TITLE: ROUGHER AND SCAVENGER FLOTATION
F16-SW-004 415V MCC
SINGLE LINE DIAGRAM SHEET 2

SHEET	SCALE	DRG No.	REVISION
A1	NONE	2000-F16-SLD-EL-10202	2

O:\CAD PROJECTS\235 NORTHERN STAR RESOURCES LTD\235I7 KCGM GROWTH PROJECT\03 DELIVERABLES\ELV\F16 - ROUGHER & SCAVENGER FLOTATION\2000-F16-SLD-EL-10202.DWG 03SEP26 2:18PM ROBINLAW