
F21-SR-001
415V CIL4 SWITCHROOM

F21-SW-007
CIL4 415V MOTOR CONTROL CENTRE No.2

CONTINUED ON SHT 2
2000-F21-SLD-EL-10252

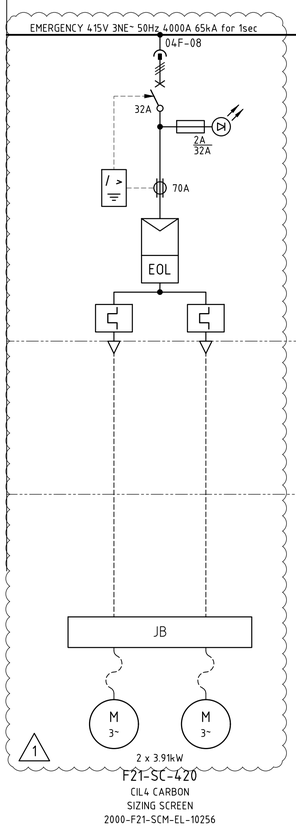

NOTES

1. REFER TO SHEET 1.

LEGEND

1. REFER TO SHEET 1.

NORTHERN STAR RESOURCES LIMITED

Approved	X
Approved as Noted	
Not Approved	
For Information Only	

Signed [redacted] Date 19/11/2025

ACCEPTANCE DOES NOT RELIEVE THE SUPPLIER / CONTRACTOR OF ITS RESPONSIBILITY OR LIABILITIES UNDER THE PURCHASE ORDER / CONTRACT

DRG No.	REFERENCES
2000-F21-SCM-EL-10254	F21-SW-007 415V MCC ARC FLASH SYSTEM SCHEMATIC DIAGRAM
2000-F21-SCM-EL-10253	F21-SW-007 415V MCC 24VDC DISTRIBUTION SCHEMATIC DIAGRAM
2000-F21-SCM-EL-10251	F21-SW-007 415V MCC INCOMER SCHEMATIC DIAGRAM
2000-F21-DRG-EL-10101	F21-SR-001 415V SWITCHROOM ELECTRICAL EQUIPMENT LAYOUT
2000-F21-BLK-IC-10001	F21-SR-001 415V SWITCHROOM AND REMOTE I/O COMMUNICATIONS BLOCK DIAGRAM
2000-F21-SLD-EL-10251	F21-SW-007 415V MCC SINGLE LINE DIAGRAM SHEET 1
2000-F00-SLD-EL-10002	F00-SW-010 33kV SWITCHBOARD SINGLE LINE DIAGRAM SHEET 1 OF 5
2000-F00-STD-EL-10001	GENERAL NOTES AND STANDARD DRAWINGS INDEX

REV	DATE	DESCRIPTION
1	20OCT25	FAT REDLINES INCORPORATED
0	28JAN25	APPROVED FOR CONSTRUCTION

DRAW	CHECK	DESIGN	TECH APP	PROJ APP
[redacted]				

NORTHERN STAR RESOURCES LIMITED

PRIMERO
primero.com.au | DESIGN | CONSTRUCT | OPERATE

PRIMERO PROJECT NUMBER: 23517

INFORMATION AND REPRESENTATIONS ON THIS DRAWING ARE THE INTELLECTUAL PROPERTY OF PRIMERO UNLESS SPECIFICALLY IDENTIFIED OTHERWISE. ALL RIGHTS INCLUDING USE RESERVED

PROJECT: NORTHERN STAR RESOURCES LTD
KCGM GROWTH PROJECT

TITLE: FLOTATION TAILINGS CIL4
F21-SW-007 415V MCC
SINGLE LINE DIAGRAM SHEET 3

SHEET	SCALE	DRG No.	REVISION
A1	NONE	2000-F21-SLD-EL-10253	1

O:\CAD PROJECTS\235 NORTHERN STAR RESOURCES LTD\23517 KCGM GROWTH PROJECT\03 DELIVERABLES\ELF21 - FLOTATION TAILINGS CIL 4\2000-F21-SLD-EL-10253.DWG 06NOV25 11:08AM HOTSEAT04