
F22-SR-001
415V CARBON TREATMENT & ELUTION SWITCHROOM

F22-SW-030
CARBON TREATMENT & ELUTION 415V MOTOR CONTROL CENTRE No.1

CONTINUED ON SHT 1
2000-F22-SLD-EL-10201

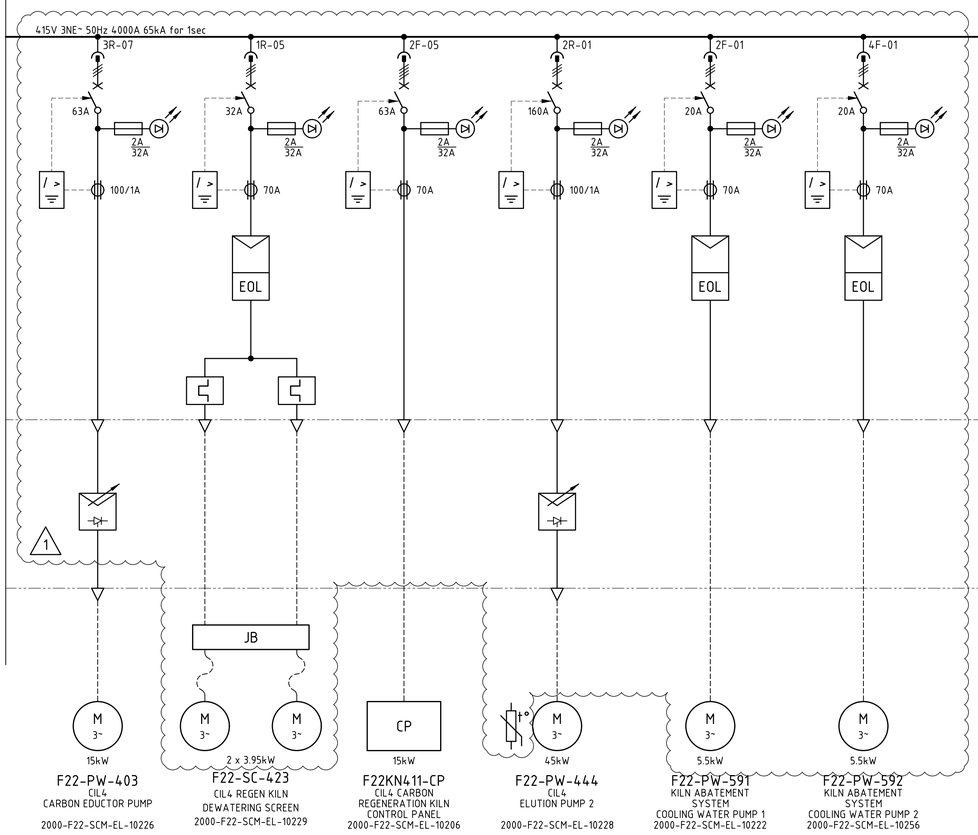

NOTES

1. REFER TO SHEET 1.

LEGEND

1. REFER TO SHEET 1.

NORTHERN STAR RESOURCES LIMITED

Approved	X
Approved as Noted	
Not Approved	
For Information Only	

Signed: [redacted] Date: 06/01/2026

ACCEPTANCE DOES NOT RELIEVE THE SUPPLIER / CONTRACTOR OF ITS RESPONSIBILITY OR LIABILITIES UNDER THE PURCHASE ORDER / CONTRACT

DRG No.	REFERENCES
2000-F22-SCM-EL-10204	F22-SW-030 415V MCC ARC FLASH SYSTEM SCHEMATIC DIAGRAM
2000-F22-SCM-EL-10203	F22-SW-030 415V MCC 24VDC DISTRIBUTION SCHEMATIC DIAGRAM
2000-F22-SCM-EL-10201	F22-SW-030 415V MCC INCOMER SCHEMATIC DIAGRAM
2000-F22-DRG-EL-10101	F22-SR-001 415V SWITCHROOM ELECTRICAL EQUIPMENT LAYOUT
2000-F22-BLK-IC-10001	F22-SR-001 415V SWITCHROOM AND REMOTE I/O COMMUNICATIONS BLOCK DIAGRAM
2000-F22-SLD-EL-10201	F22-SW-030 415V MCC SINGLE LINE DIAGRAM SHEET 1
2000-F00-SLD-EL-10002	F00-SW-010 33kV SWITCHBOARD SINGLE LINE DIAGRAM SHEET 1 OF 5
2000-F00-STD-EL-10001	GENERAL NOTES AND STANDARD DRAWINGS INDEX

REV	DATE	DESCRIPTION	DRAW	CHECK	DESIGN	TECH APP	PROJ APP
1	24NOV25	FAT REDLINES INCORPORATED					
0	05NOV24	APPROVED FOR CONSTRUCTION					

NORTHERN STAR RESOURCES LIMITED

PRIMERO
primero.com.au | DESIGN | CONSTRUCT | OPERATE

PRIMERO PROJECT NUMBER: 23517

INFORMATION AND REPRESENTATIONS ON THIS DRAWING ARE THE INTELLECTUAL PROPERTY OF PRIMERO UNLESS SPECIFICALLY IDENTIFIED OTHERWISE. ALL RIGHTS INCLUDING USE RESERVED

PROJECT: NORTHERN STAR RESOURCES LTD
KCGM GROWTH PROJECT

TITLE: CIL4 CARBON TREATMENT & ELUTION
F22-SW-030 415V MCC
SINGLE LINE DIAGRAM SHEET 2

SHEET	SCALE	DRG No.	REVISION
A1	NONE	2000-F22-SLD-EL-10202	1

O:\CAD PROJECTS\235 NORTHERN STAR RESOURCES LTD\23517 KCGM GROWTH PROJECT\03 DELIVERABLES\ELV\F22 - CIL4 CARBON TREAMENT & ELUTION\2000-F22-SLD-EL-10202.DWG 18DEC25 12:14PM HOTSEAT04