
F23-SR-002
415V FINAL TAILS PUMPS SWITCHROOM

F23-SW-023
FINAL TAILS PUMPS 415V MOTOR CONTROL CENTRE

CONTINUED ON SHT 1
2000-F23-SLD-EL-10201

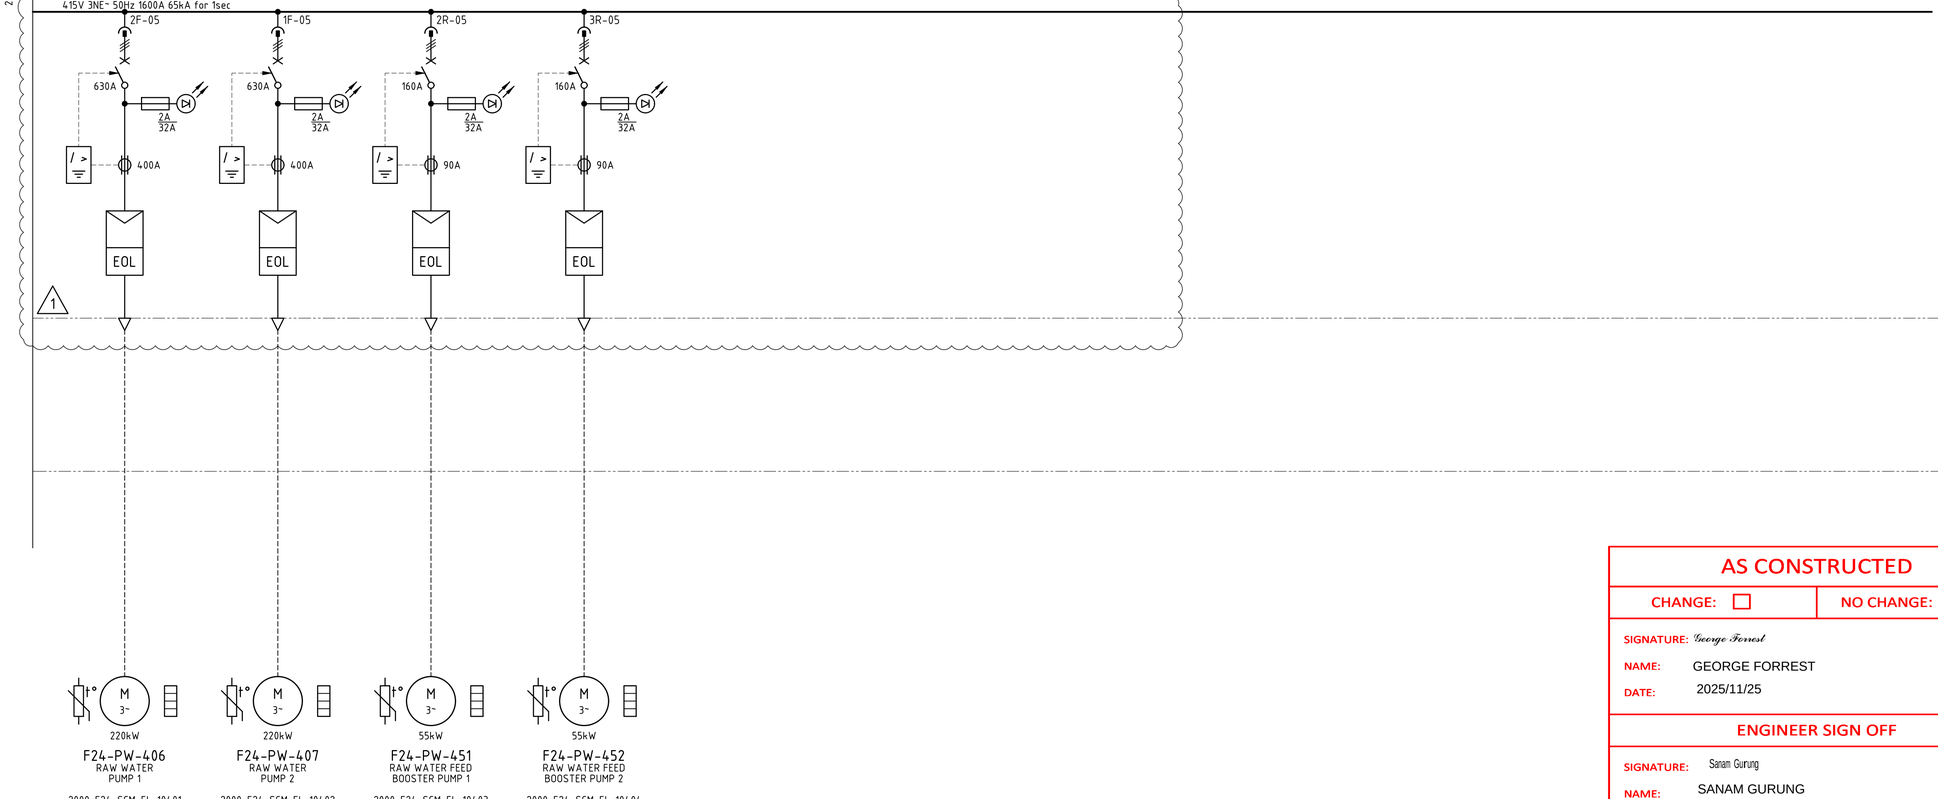

NOTES

1. REFER TO SHEET 1.

LEGEND

1. REFER TO SHEET 1.

AS CONSTRUCTED

CHANGE: ☐ NO CHANGE: ☒

SIGNATURE: George Forrest
NAME: GEORGE FORREST
DATE: 2025/11/25

ENGINEER SIGN OFF

SIGNATURE: Sanam Gurung
NAME: SANAM GURUNG
DATE: 2025/11/25

DRG No.	REFERENCES	REV	DATE	DESCRIPTION
2000-F23-SCM-EL-10203	F23-SW-023 415V MCC ARC FLASH SYSTEM SCHEMATIC DIAGRAM			
2000-F23-SCM-EL-10202	F23-SW-023 415V MCC 24VDC DISTRIBUTION SCHEMATIC DIAGRAM			
2000-F23-SCM-EL-10201	F23-SW-023 415V MCC INCOMER SCHEMATIC DIAGRAM			
2000-F23-DRG-EL-10001	F23-SR-002 415V SWITCHROOM ELECTRICAL EQUIPMENT LAYOUT			
2000-F23-BLK-IC-10001	F23-SR-001 415V SWITCHROOM AND REMOTE I/O COMMUNICATIONS BLOCK DIAGRAM			
2000-F23-SLD-EL-10201	F23-SW-023 415V MCC SINGLE LINE DIAGRAM SHEET 1	RL1	25/11/25	As constructed for sub-systemF23.10.09 FOR SP1
2000-F00-SLD-EL-10002	F00-SW-010 33kV SWITCHBOARD SINGLE LINE DIAGRAM SHEET 1 OF 5	1	19SEP25	FAT REDLINES INCORPORATED
2000-F00-STD-EL-10001	GENERAL NOTES AND STANDARD DRAWINGS INDEX	0	30MAY24	APPROVED FOR CONSTRUCTION

DRAW | CHECK | DESIGN | TECH APP | PROJ APP

NORTHERN STAR RESOURCES LIMITED

PRIMERO
primero.com.au | DESIGN | CONSTRUCT | OPERATE

PRIMERO PROJECT NUMBER: 23517

INFORMATION AND REPRESENTATIONS ON THIS DRAWING ARE THE INTELLECTUAL PROPERTY OF PRIMERO UNLESS SPECIFICALLY IDENTIFIED OTHERWISE. ALL RIGHTS INCLUDING USE RESERVED

PROJECT: NORTHERN STAR RESOURCES LTD
KCGM GROWTH PROJECT

TITLE: FINAL TAILS HANDLING AND STORAGE
F23-SW-023 415V MCC
SINGLE LINE DIAGRAM SHEET 2

SHEET	SCALE	DRG No.	REVISION
A1	NONE	2000-F23-SLD-EL-10202	1 RL1

O:\CAD PROJECTS\235 NORTHERN STAR RESOURCES LTD\23517 KCGM GROWTH PROJECT\03 DELIVERABLES\ELF23 - FINAL TAILINGS HANDLING & STORAGE\2000-F23-SLD-EL-10202.DWG 020CT25 9:04AM HOTSEAT04