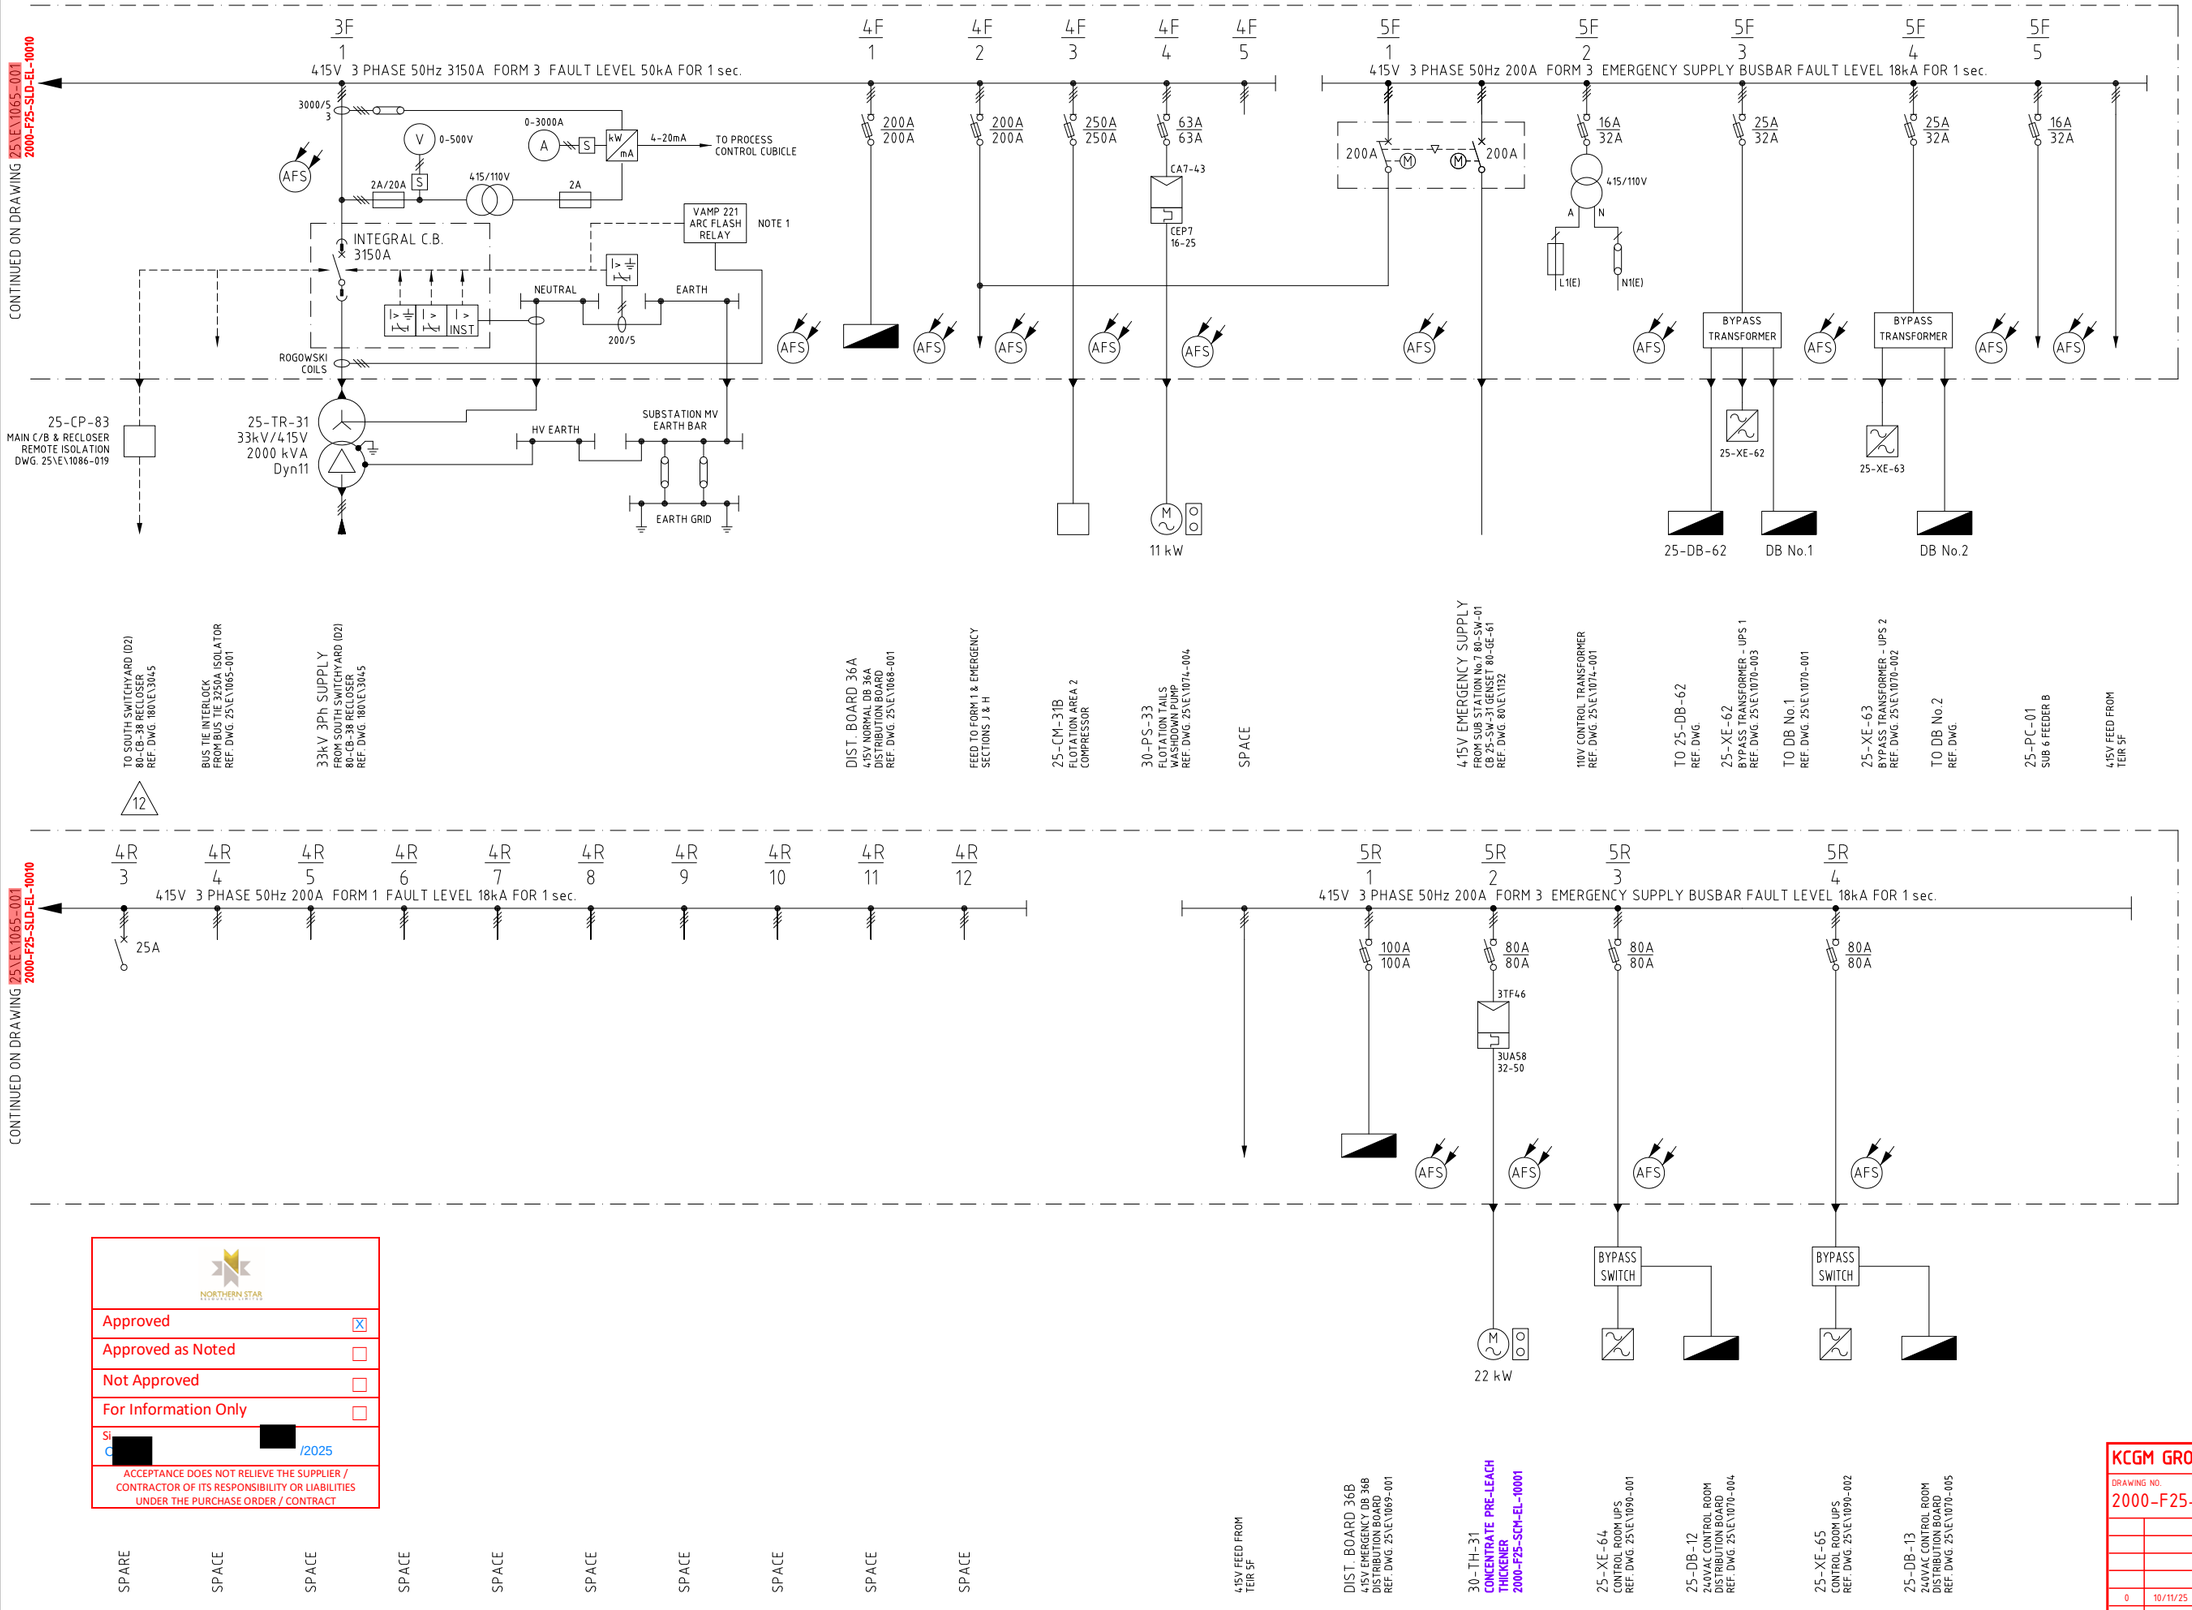


NORTHERN STAR RESOURCES LIMITED

Approved	X
Approved as Noted	
Not Approved	
For Information Only	

Si [redacted] /2025


ACCEPTANCE DOES NOT RELIEVE THE SUPPLIER / CONTRACTOR OF ITS RESPONSIBILITY OR LIABILITIES UNDER THE PURCHASE ORDER / CONTRACT

LEGEND

LOCATION

SUB STATION 6

25-SW-31

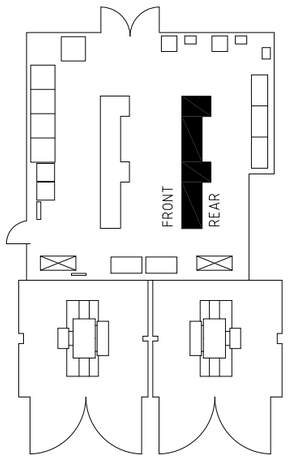

NOTES

1. ALL AFS (ARC FLASH SENSORS) ARE CONNECTED TO THE ARC FLASH RELAY VIA I/O UNITS

LEGEND
- EXISTING
- NON-EXISTENT
- STAGE 1 - NEW
- STAGE 1 - REMOVE
- STAGE 1 - DECOMMISSIONED (OTHERS)
- STAGE 2 - NEW
- STAGE 2 - REMOVE
- STAGE 2 - DECOMMISSIONED (OTHERS)

KCGM GROWTH PROJECT

DRAWING NO. 2000-F25-SLD-EL-10011

REV	DATE	DESCRIPTION	CHECK	TECH APP
0	10/11/25	APPROVED FOR CONSTRUCTION	[redacted]	DM

MK	DATE	REVISION	BY	CKD	APP
12	27/10/21	RECLOSER PROJECT AS BUILT	RH	RH	MM
11	08/10/19	2019 S.L.D. UPDATE PROJECT "AS BUILT"		RH	
10	08/08/19	2019 S.L.D. UPDATE PROJECT "AS BUILT"- FIELD REVIEW		RH	
9	12/07/18	ARC FLASH SENSOR S INSTALLED		JMR	
8	21/10/14	25CM31B RELOCATED FROM 2F/1 TO 4F/3 DURING SHUTDOWN		SK	
7	22/05/14	AS BUILT		SK	

MK	DATE	REVISION	BY	CKD	APP
6	08/04/09	CONTROL ROOM UPGRADE	TW		
5	29/10/07	DCS UPGRADE ALTERATIONS			
4	09/11/04	AS BUILT 2004			
3	15/01/03	UPDATE EMERGENCY SUPPLY CHANGES			
2	03/02/01	MINOR CHANGES ADDED	SDES	AB	
1	01/10/00	ASBUILT MODIFICATION ADDED		KCGM	KCGM

REFERENCE DRAWINGS

DWG NO.

SCALE	NTS	
DRAWN		01/10/00
DESIGNED	KCGM	01/10/00
CHECKED	KCGM	01/10/00
APPROVED	KCGM	01/10/00
PROJ.APP	KCGM	01/10/00
PROJ. FILE #.		

FIMISTON PLANT
FLOTATION
SUBSTATION No.6 415V MCC 25SW31
SINGLE LINE DIAGRAM

SIZE	DRAWING NUMBER	REV
A1	25\E\1065-002	12

KALGOORLIE CONSOLIDATED GOLD MINES PTY. LTD. ABN 009 377 619 003