00F 1 | 00F 2 | 00F 3 | 00F 4 — EMERGENCY 415V 3 PHASE 50Hz 200A FORM 4 FAULT LEVEL 18kA FOR 1 sec. FED FROM 2F/2

1F 1 | 1F 2 | 1F 3 | 1F 4 | 1F 5 | 1F 6 | 1F 7 | 1F 8 | 1F 9 | 1F 10 | 1F 11 | 1F 12 — 415V 3 PHASE 50Hz 200A FORM 1 FAULT LEVEL 18kA FOR 1 sec. 60 WAY CHASIS FED FROM 2F/2

CONTINUED ON DRAWING 30\E\1321-002

100A | 16A/32A | 32A/32A | 63A | 100A

415/110V 1500VA | 20A | L1E | N1E | 240 V

AFS

A 32A

30-PC-31 | 30-XE-63 | 30-DB-31 | 30-PC-61

BYPASS SWITCH & TRANSFORMER | 240V | 110V

1F 1: (4) 50A 3TF43 3UA50 8-12.5

1F 2: (4) 50A 3TB41 3UA50 8-12.5 3UA50 8-12.5

1F 3: (4) 50A 3TF42 3UA50 6.3-10 3UA50 6.3-10 — JB — FLEX — M — 4 kW 4 kW

1F 4: (4) 5A 3TB40 3UA50 .4-.63

1F 5: (4) 5A 3TB40 3UA50 .4-.63

1F 6: (4) 40A 3TF44 3UA55 25-36

1F 7: (4) 5A 3TB40 (2)

1F 8: (4) 50A 3TF43 3UA52 16-25

1F 9: (4) 32A 3TF42 3UA52 12.5-20

1F 10: (4) 32A 3TF43 3UA52 12.5-20

1F 11: (4) 25A 3TF44 3UA59 18-25 3UA50 12.5-20

1F 12: (4) 25A

415V EMERGENCY SUPPLY
FROM SUBSTATION No.38
80-SW-31
REF. DWG. 30\E\1331-001

MCC 110V AC BUS
VIA 30-PC-31
REF. DWG. 30\E\1341-001

30-XE-63
240V SUPPLY TO UPS
REF. DWG. 30\E\1341-001

30-PC-61
110V CONDITIONED SUPPLY TO DCS
REF. DWG. 30\E\1341-001

F30-XE-32
SUBSTATION No.38 240V
UN INTERRUPTABLE POWER SUPPLY
REF. DWG. 30\E\1194-002

7

F30-XE-32F
SUBSTATION No.38 240V/110V
PROTECTION EQUIPMENT SUPPLY
REF. DWG. 30\E\1152-002

415V 3 PHASE SUPPLY
FROM SUBSTATION No.38
30-SW-31 TIER 2F/2
REF. DWG. 30\E\1321-002

SPARE | SPARE | 65-SC-31 LOADED CARBON SCREEN REF. DWG. 30\E\1341-003 | SPARE | SPARE | SPARE | SPARE | SPARE | SPARE | SPARE | SPARE | SPARE

00R 1 | 00R 2 | 00R 3 — EMERGENCY 415V 3 PHASE 50Hz 200A FORM 4 FAULT LEVEL 18kA FOR 1 sec. FED FROM 2F/2

1R 1 | 1R 2 | 1R 3 | 1R 4 | 1R 5 | 1R 6 | 1R 7 | 1R 8 | 1R 9 | 1R 10 | 1R 11 | 1R 12 — 415V 3 PHASE 50Hz 200A FORM 1 FAULT LEVEL 18kA FOR 1 sec. 60 WAY CHASIS FED FROM TIER 2F/2

CONTINUED ON DRAWING 30\E\1321-002

100A | 80A/125A | NOTE C.1. | 100A

DB38B EMERGENCY

AFS

NOTE C.1. — CIL 2 MAINT BAY

1R 1: (4) 25A 3TB40 3UA50 6.3-10

1R 2: (4) 32A — 25A — 65-HC-70 — M — 4 kW

1R 3: (4) 25A 3TB40 3UA50 5-8

1R 4: (4) 25A 3TB40 3UA50 5-8

1R 5: (4) 25A 3TB40 3UA50 5-8

1R 6: (4) 25A 3TB40 3UA50 5-8

1R 7: (4) 25A 3TB40 3UA50 5-8

1R 8: (4) 25A 3TB40 3UA50 5-8

1R 9: (4) 25A 3TB40 3UA50 5-8

1R 10: (4) 25A 3TB40 3UA50 5-8

1R 11: (4)

1R 12: (4)

EMERGENCY DISTRIBUTION BOARD No.38B
REF. DWG. 30\E\1331-003

CIL 2 KEMIX SCREEN
MAINTENANCE BAY CONTROL PANEL

SPACE

65-AG-70
CARBON ATTRITION AGITATOR
REF. DWG. 30\E\1341-013

65-HC-70
CARBON ATTRITION HOIST
REF. DWG. 30\E\1341-014

SPARE | SPARE | SPARE | SPARE | SPARE | SPARE | SPARE | SPARE | SPACE | SPACE

Approved	X
Approved as Noted	
Not Approved	
For Information Only	


Signed: C Laird — Date: 20/11/2025

ACCEPTANCE DOES NOT RELIEVE THE SUPPLIER / CONTRACTOR OF ITS RESPONSIBILITY OR LIABILITIES UNDER THE PURCHASE ORDER / CONTRACT

LEGEND

LOCATION

SUB STATION 38
30-SW-31

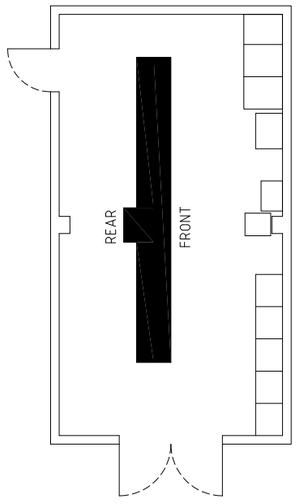

NOTES

1. WHERE DRIVES & FEEDERS REQUIRE 2 OFF CIRCUIT BREAKER AUXILLARIES THEN AN ADDITIONAL POLE SPACE IS REQUIRED.
 No. OF POLES USED SHOWN IN BRACKETS.
2. ALL AFS (ARC FLASH SENSORS) ARE CONNECTED TO THE ARC FLASH RELAY VIA I/O UNITS

LEGEND
- EXISTING
- NON-EXISTENT
- STAGE 1 - NEW
- STAGE 1 - REMOVE
- STAGE 1 - DECOMMISSIONED (OTHERS)
- STAGE 2 - NEW
- STAGE 2 - REMOVE
- STAGE 2 - DECOMMISSIONED (OTHERS)

KCGM GROWTH PROJECT CONSTRUCTION NOTES
C.1. INSTALLED CABLES TO BE DISCONNECTED AND MADE SAFE AT BOTH ENDS.

KCGM GROWTH PROJECT
DRAWING NO.
2000-F30-SLD-EL-10202

REV	DATE	DESCRIPTION	CHECK	TECH APP
0	10/11/25	APPROVED FOR CONSTRUCTION		DM

MK	DATE	REVISION	BY	CKD	APP
8	11/05/20	ISSUED FOR CONSTRUCTION		AA	
7B	12/03/20	UPDATED WITH UPS	JJ	DS	
7A	27/03/20	NEW UPS INSTALLED AT 00F/4		AA	
6A	21/08/19	2019 S.L.D. UPDATE PROJECT "AS BUILT"- FIELD REVIEW	BH	RH	EB
5	17/07/18	ARC FLASH SENSORS INSTALLED		JMR	
4	13/08/03	1R/2 CB ALTERED TO 32A			
3	30/06/03	APPROVED FOR CONSTRUCTION - PROJECT 155/04861		DBG	
2	20/05/03	ISSUED FOR TENDER - PROJECT No.155-04861		LD	
1	01/09/01	ASBUILD MODIFICATIONS ADDED		AB	

REFERENCE DRAWINGS | DWG NO. | PROJ. FILE #.

SCALE	NTS	
DRAWN	KCGM	01/09/01
DESIGNED	KCGM	01/09/01
CHECKED	KCGM	01/09/01
APPROVED	KCGM	01/09/01
PROJ.APP	KCGM	01/09/01

FIMISTON PLANT
LEACH ADSORPTION & THICKENING
SUBSTATION No. 38 MCC 30-SW-31
SINGLE LINE DIAGRAM

SIZE	DRAWING NUMBER	REV
A1	30\E\1321-001	8

KALGOORLIE CONSOLIDATED GOLD MINES PTY. LTD. ABN 009 377 619 003