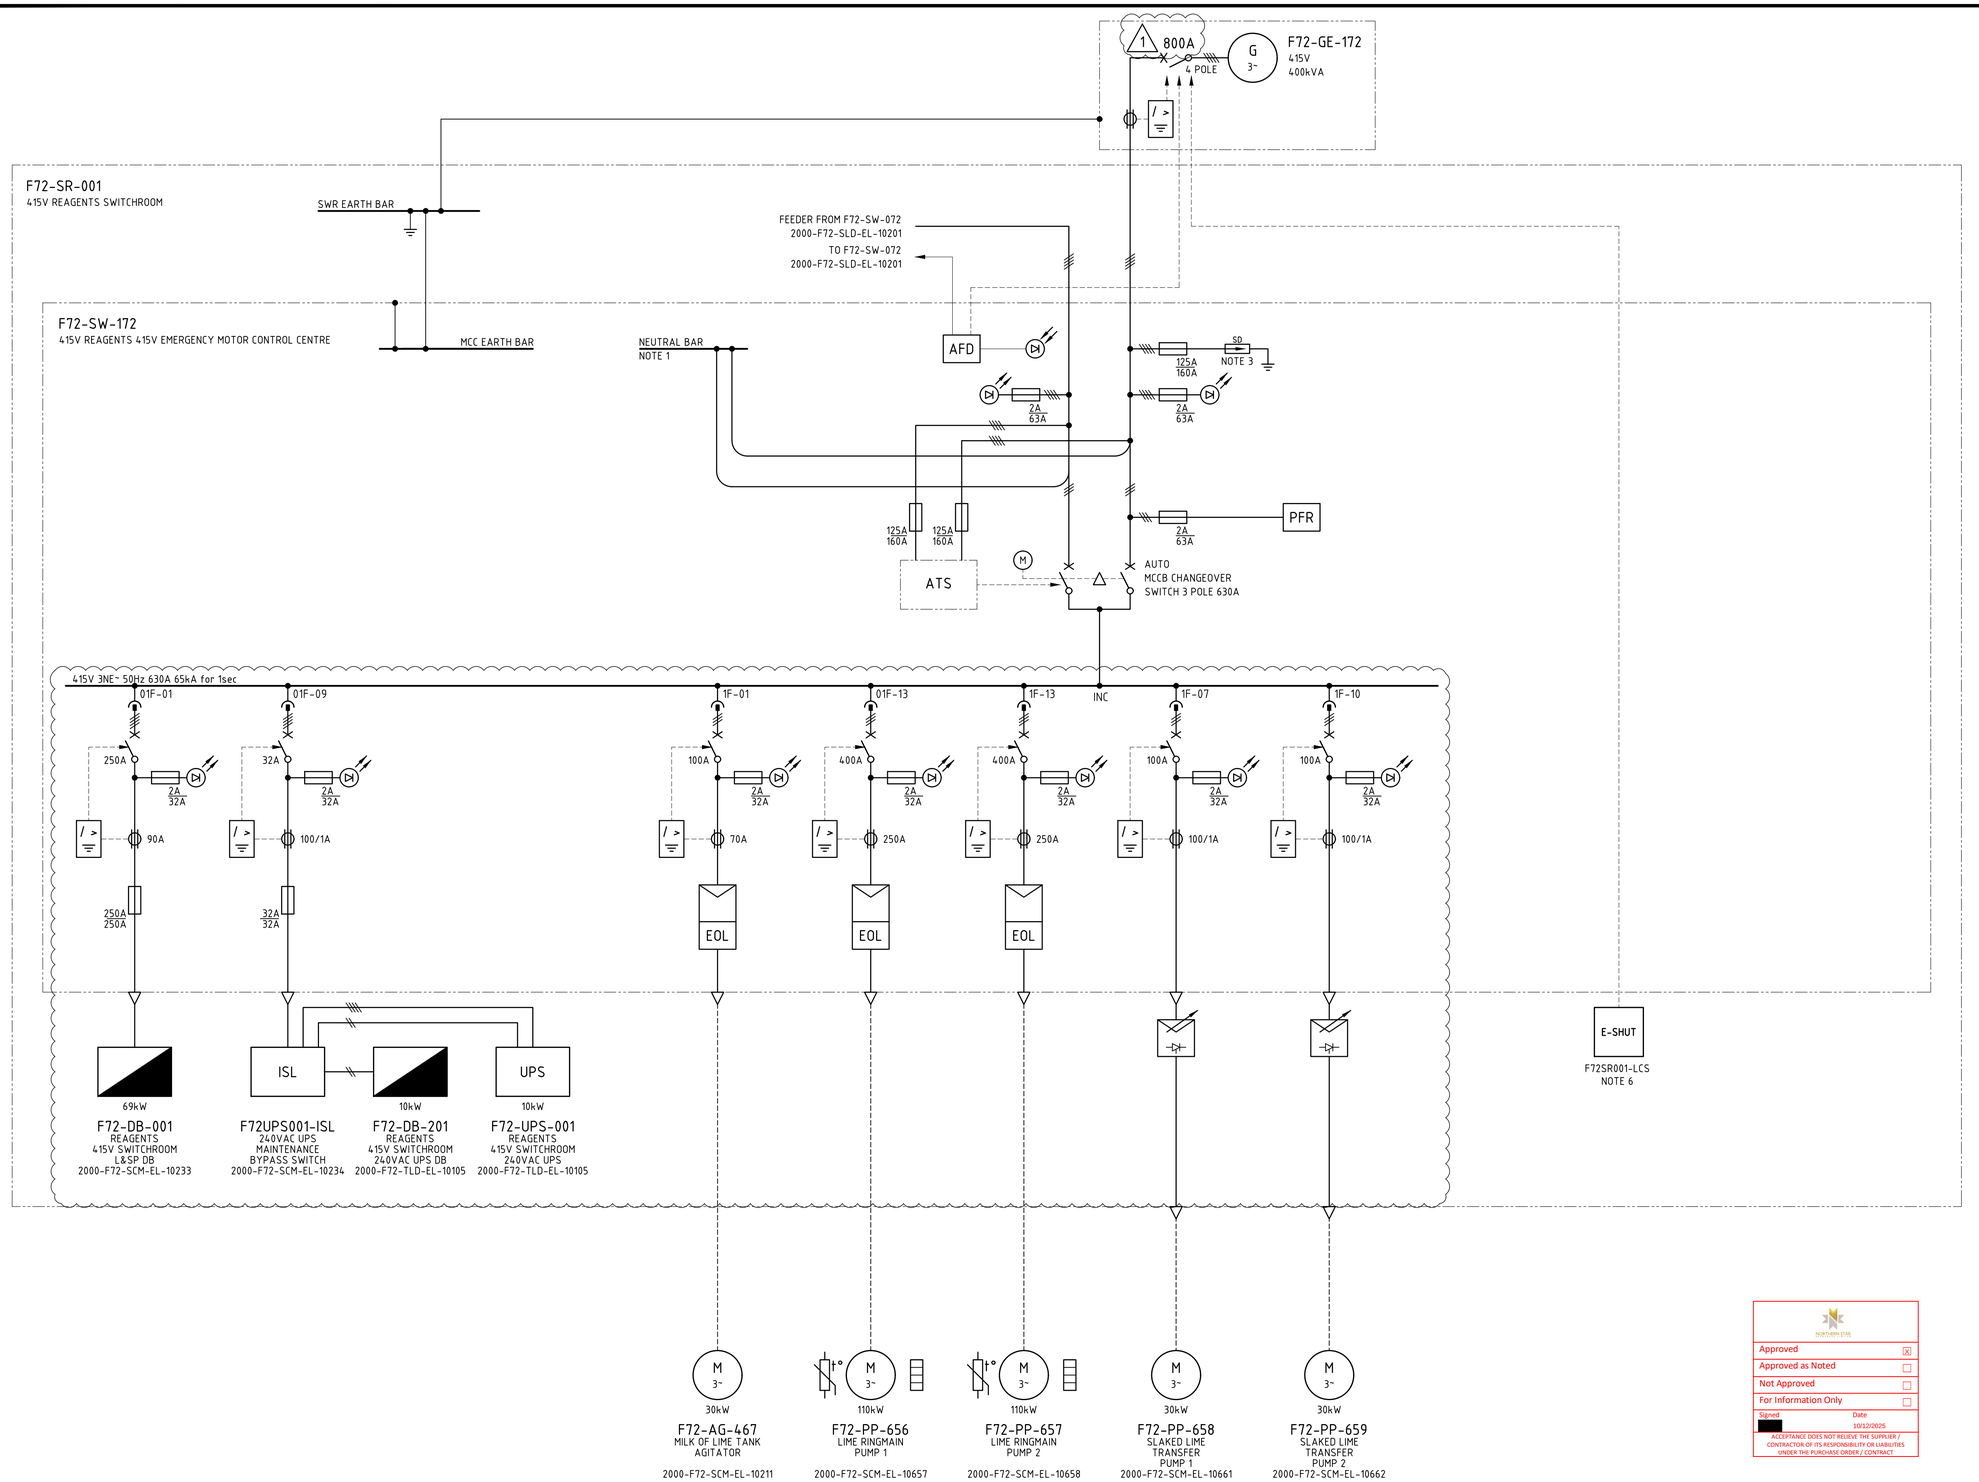


NOTES

1. EARTH-NEUTRAL LINK INSTALLED IN UPSTREAM F72-SW-072 INCOMER TIER. SIGNAGE SHALL BE PLACED ON F72-SW-172 SWITCHBOARD AND ON GENERATOR READING "M.E.N. LINK LOCATED IN F72-SW-072 INCOMER TIER"
2. SWITCHBOARD SHALL BE EXTENSIBLE AND BE PROVIDED WITH THE FACILITY TO EXTEND THE MAIN BUSBAR AND APPEND ADDITIONAL TIERS AT ONE END WITHOUT MAJOR STRUCTURAL DISASSEMBLY.
3. SURGE DIVERTERS SHALL PROVIDE FEEDBACK TO DCS VIA VOLT-FREE CONTACTS. SURGE DIVERTER FUSES SHALL BE SIZED BY VENDOR TO SUIT DUTY.
4. MINIATURE CIRCUIT BREAKERS SHALL BE SIZED AND RATED TO SUIT ACB AND INCOMER REQUIREMENTS.
5. CIRCUIT BREAKER TO BE SUBSTITUTED FOR FUSED-SWITCH WHERE REQUIRED BY EQUIPMENT MANUFACTURERS GUIDELINES.
6. EMERGENCY SHUTDOWN (E-SHUT) PUSH BUTTON WIRED TO SHUNT TRIP NOMINATED CIRCUIT BREAKERS.

LEGEND

PFR	PHASE FAILURE RELAY
/ >	EARTH LEAKAGE RELAY
xxxA / xxxA	ST TRIP SET POINT / CB SIZE
AFD	ARC FLASH DETECTION
ECR	EARTH CONTINUITY RELAY
E-SHUT	SWITCHROOM EMERGENCY SHUTDOWN

NORTHERN STAR

Approved	☒
Approved as Noted	☐
Not Approved	☐
For Information Only	☐

Signed [redacted] Date 10/12/2025

ACCEPTANCE DOES NOT RELIEVE THE SUPPLIER / CONTRACTOR OF ITS RESPONSIBILITY OR LIABILITIES UNDER THE PURCHASE ORDER / CONTRACT

DRG No.	REFERENCES
2000-F72-SCM-EL-10225	F72-SW-072 415V ARC FLASH SYSTEM SCHEMATIC DIAGRAM
2000-F72-SCM-EL-10224	F72-SW-072 415V 24VDC DISTRIBUTION SCHEMATIC DIAGRAM
2000-F72-SCM-EL-10231	F72-SW-172 415V EMERGENCY MCC INCOMER SCHEMATIC DIAGRAM SHEET 1
2000-F72-DRG-EL-10001	F72-SR-001 415V SWITCHROOM ELECTRICAL EQUIPMENT LAYOUT
2000-F72-BLK-IC-10001	F72-SR-001 415V SWITCHROOM AND REMOTE I/O COMMUNICATIONS BLOCK DIAGRAM
2000-F72-SLD-EL-10201	F72-SW-072 415V MCC SINGLE LINE DIAGRAM SHEET 1
2000-F00-SLD-EL-10002	F00-SW-010 33kV SWITCHBOARD SINGLE LINE DIAGRAM SHEET 1
2000-F00-STD-EL-10001	GENERAL NOTES AND STANDARD DRAWINGS INDEX

REV	DATE	DESCRIPTION	DRAW	CHECK	DESIGN	TECH APP	PROJ APP
1	04NOV25	FAT REDLINES INCORPORATED					
0	07MAR25	APPROVED FOR CONSTRUCTION					

NORTHERN STAR RESOURCES LIMITED

PRIMERO
primero.com.au | DESIGN | CONSTRUCT | OPERATE

PRIMERO PROJECT NUMBER: 23517

INFORMATION AND REPRESENTATIONS ON THIS DRAWING ARE THE INTELLECTUAL PROPERTY OF PRIMERO UNLESS SPECIFICALLY IDENTIFIED OTHERWISE. ALL RIGHTS INCLUDING USE RESERVED

PROJECT: NORTHERN STAR RESOURCES LTD
KCGM GROWTH PROJECT

TITLE: REAGENTS MIXING & STORAGE
F72-SW-172 415V EMERGENCY MCC
SINGLE LINE DIAGRAM

SHEET	SCALE	DRG No.	REVISION
A1	NONE	2000-F72-SLD-EL-10211	1

O:\CAD PROJECTS\235 NORTHERN STAR RESOURCES LTD\23517 KCGM GROWTH PROJECT\03 DELIVERABLES\EL\F72 - REAGENTS MIXING & STORAGE\2000-F72-SLD-EL-10211.DWG 03DEC25 12:39PM HOTSEAT04