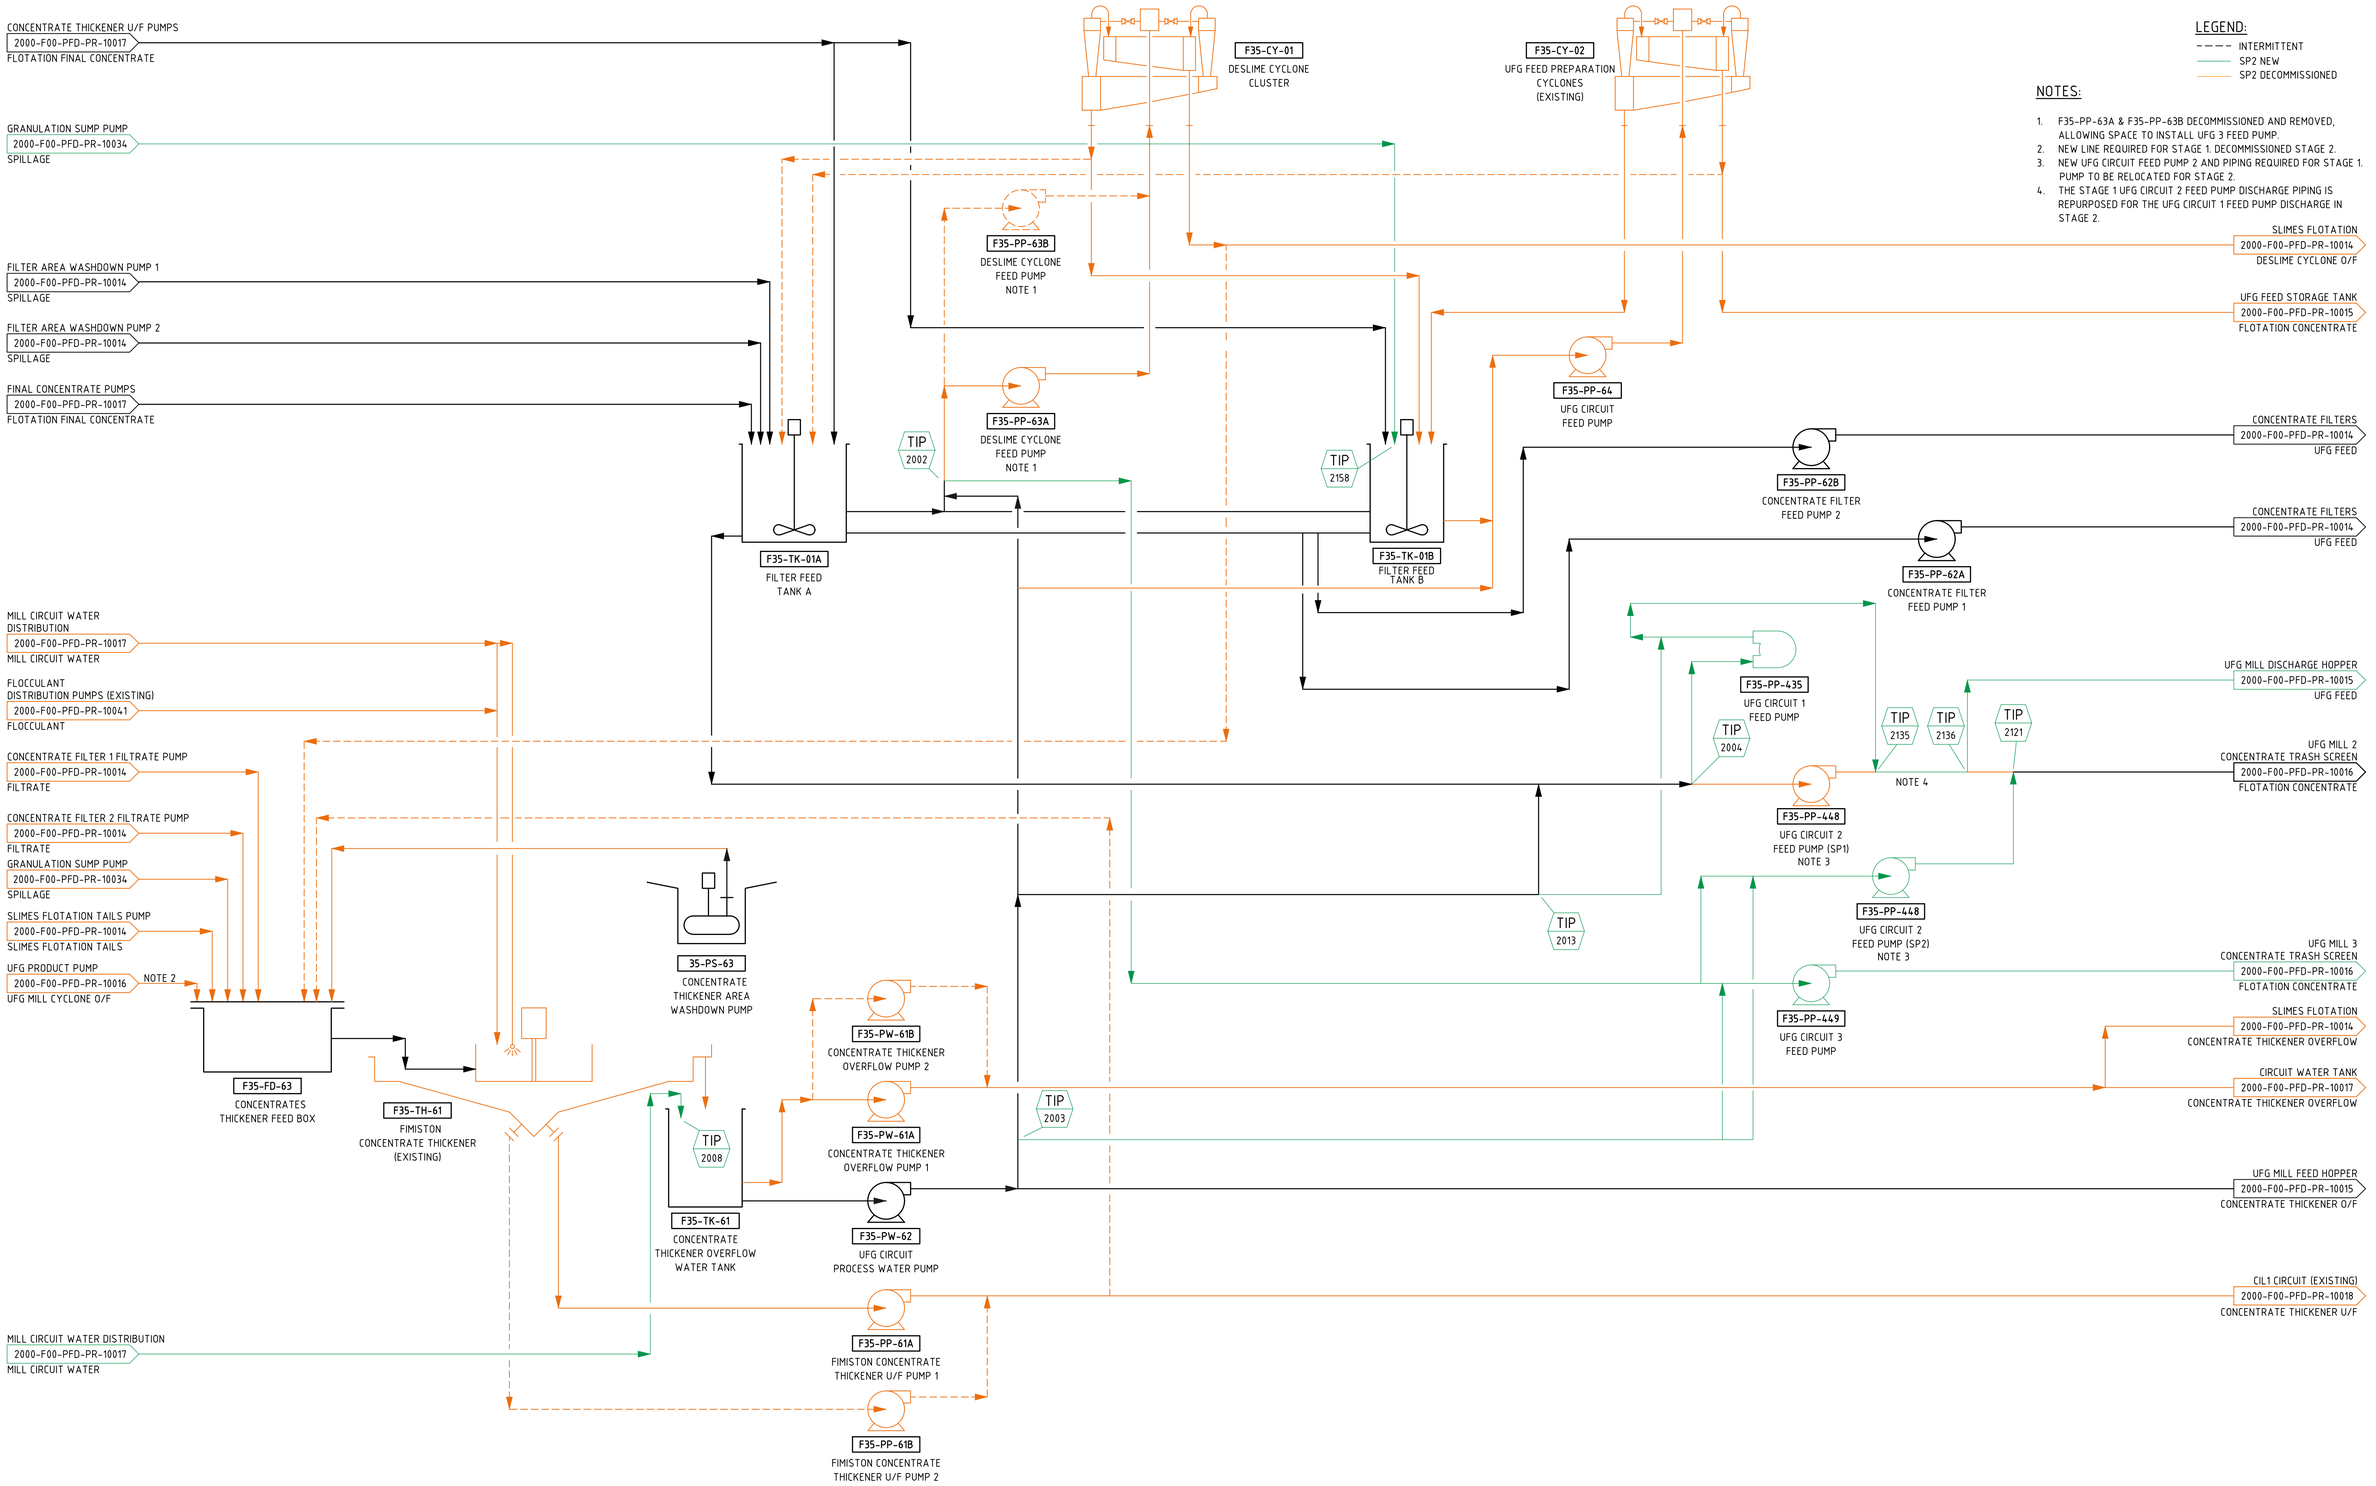



| DRG No. | REFERENCES |
|---|---|
| 2000-F00-PID-PR-10007 | LEGEND SHEET 7 - PIPING AND INSTRUMENTATION DIAGRAM |
| 2000-F00-PID-PR-10006 | LEGEND SHEET 6 - PIPING AND INSTRUMENTATION DIAGRAM |
| 2000-F00-PID-PR-10005 | LEGEND SHEET 5 - PIPING AND INSTRUMENTATION DIAGRAM |
| 2000-F00-PID-PR-10004 | LEGEND SHEET 4 - PIPING AND INSTRUMENTATION DIAGRAM |
| 2000-F00-PID-PR-10003 | LEGEND SHEET 3 - PIPING AND INSTRUMENTATION DIAGRAM |
| 2000-F00-PID-PR-10002 | LEGEND SHEET 2 - PIPING AND INSTRUMENTATION DIAGRAM |
| 2000-F00-PID-PR-10001 | LEGEND SHEET 1 - PIPING AND INSTRUMENTATION DIAGRAM |

| REV | DATE | DESCRIPTION | DRAW | CHECK | DESIGN | TECH APP | PROJ APP |
|---|---|---|---|---|---|---|---|
| 1 | 04SEP25 | SP1 AS BUILT | | | | | |
| 0 | 10APR25 | ISSUED FOR DESIGN | | | | | |

NORTHERN STAR RESOURCES LIMITED

PRIMERO
primero.com.au | DESIGN | CONSTRUCT | OPERATE

PRIMERO PROJECT NUMBER: 23517

INFORMATION AND REPRESENTATIONS ON THIS DRAWING ARE THE INTELLECTUAL PROPERTY OF PRIMERO UNLESS SPECIFICALLY IDENTIFIED OTHERWISE. ALL RIGHTS INCLUDING USE RESERVED

PROJECT: NORTHERN STAR RESOURCES LTD
KCGM GROWTH PROJECT

TITLE: CONCENTRATE STORAGE AND FILTRATION PROCESS FLOW DIAGRAM

| SHEET | SCALE | DRG No. | REVISION |
|---|---|---|---|
| A1 | N.T.S. | 2000-F00-PFD-PR-10013 | 1 |

O:\CAD PROJECTS\235 NORTHERN STAR RESOURCES LTD\23517 KCGM GROWTH PROJECT\03 DELIVERABLES\PRP\PFD\AS BUILT\2000-F00-PFD-PR-10013.DWG 04SEP26 1:58PM ANNE HOYNE