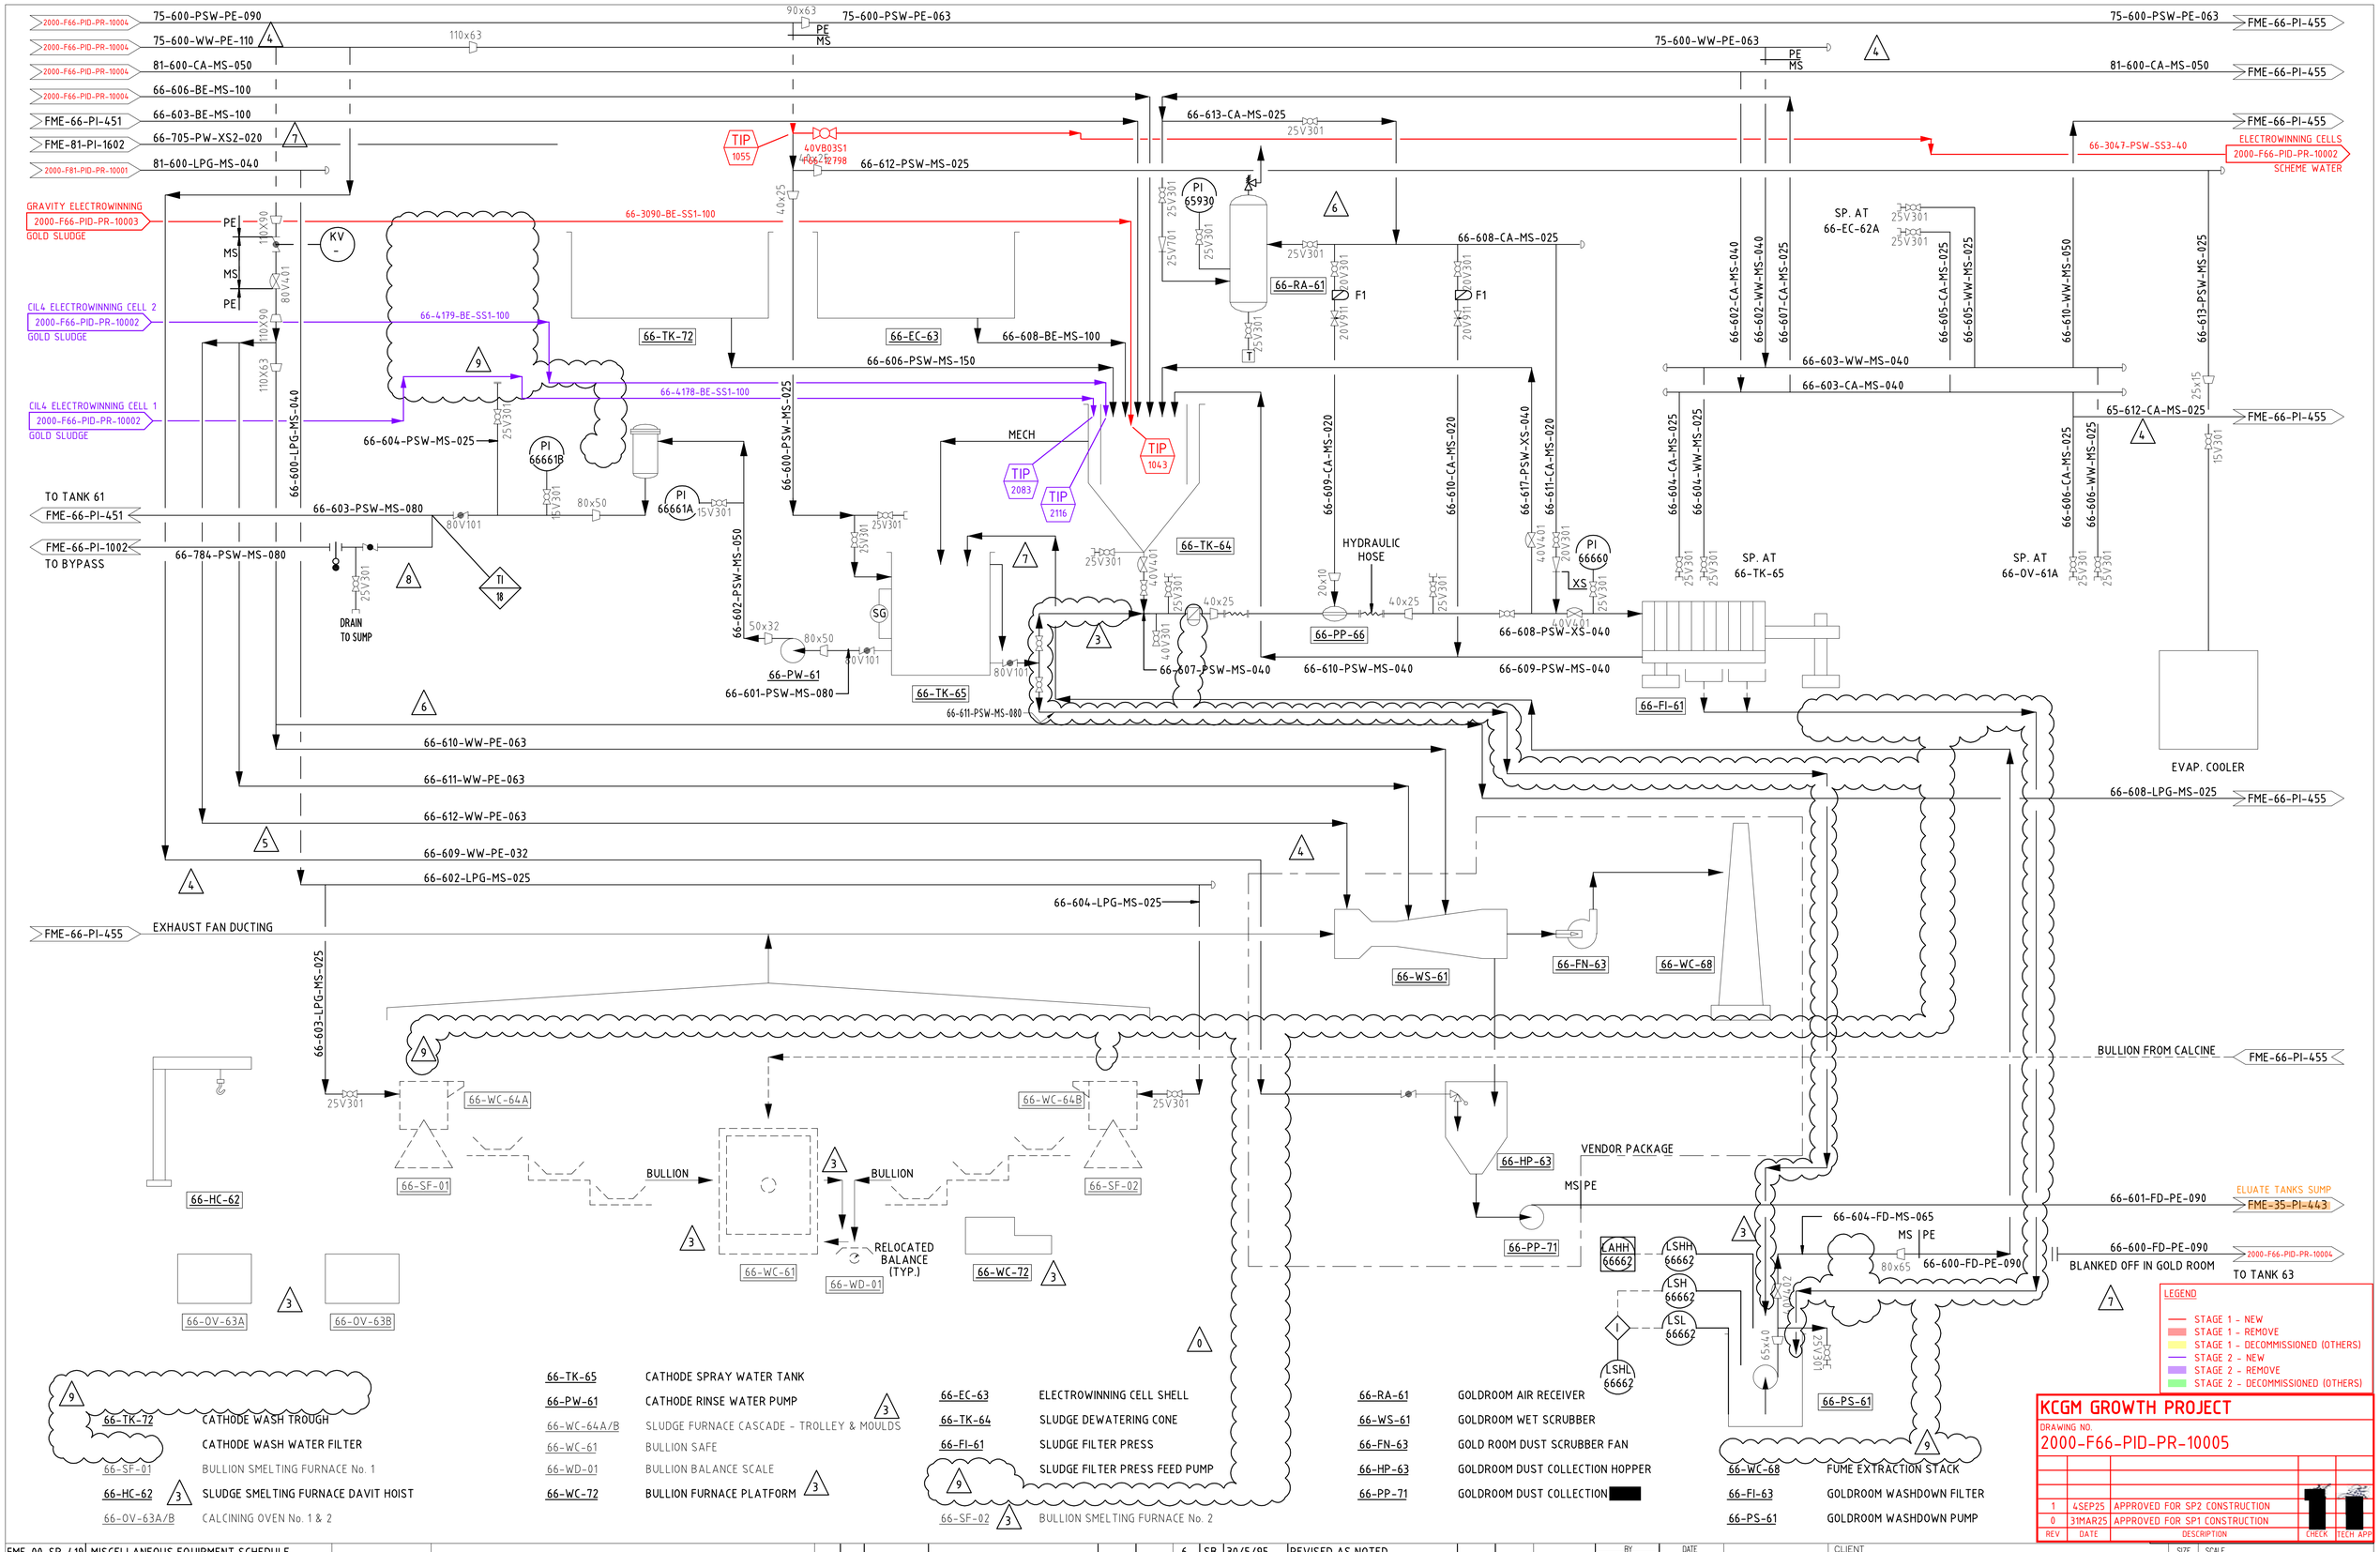


66-TK-72	CATHODE WASH TROUGH	66-TK-65	CATHODE SPRAY WATER TANK
	CATHODE WASH WATER FILTER	66-PW-61	CATHODE RINSE WATER PUMP
66-SF-01	BULLION SMELTING FURNACE No. 1	66-WC-64A/B	SLUDGE FURNACE CASCADE - TROLLEY & MOULDS
66-HC-62	SLUDGE SMELTING FURNACE DAVIT HOIST	66-WC-61	BULLION SAFE
66-OV-63A/B	CALCINING OVEN No. 1 & 2	66-WD-01	BULLION BALANCE SCALE
		66-WC-72	BULLION FURNACE PLATFORM

66-EC-63	ELECTROWINNING CELL SHELL	66-RA-61	GOLDROOM AIR RECEIVER
66-TK-64	SLUDGE DEWATERING CONE	66-WS-61	GOLDROOM WET SCRUBBER
66-FI-61	SLUDGE FILTER PRESS	66-FN-63	GOLD ROOM DUST SCRUBBER FAN
	SLUDGE FILTER PRESS FEED PUMP	66-HP-63	GOLDROOM DUST COLLECTION HOPPER
66-SF-02	BULLION SMELTING FURNACE No. 2	66-PP-71	GOLDROOM DUST COLLECTION [redacted]

66-WC-68	FUME EXTRACTION STACK		
66-FI-63	GOLDROOM WASHDOWN FILTER		
66-PS-61	GOLDROOM WASHDOWN PUMP		

FME-00-SP-419	MISCELLANEOUS EQUIPMENT SCHEDULE
FME-00-SP-415	MANUAL VALVE SCHEDULE
FME-00-SP-411	PIPING LINE LIST
FME-00-P-401	PIPING KEYPLAN
FME-00-SP-408	INSTRUMENT STANDARDS
FME-00-SP-404	STANDARD ABBREV. & VALVE SYMBOLS
FME-00-SP-403	STANDARD EQUIPMENT SYMBOLS
DRAWING No.	REFERENCE DRAWINGS

COPYRIGHT ©
This drawing remains the property of MINPROC ENGINEERS LIMITED and may not be copied in any way without prior written approval from this company.

MINPROC ENGINEERS LIMITED
A.C.N. 008 992 694
22, STIRLING HIGHWAY, NEDLANDS WA 6009
PHONE (09) 347 4777

No.	BY	DATE	REVISION	CHECKED
9	[redacted]	04.05.2020	EQUIPMENT REMOVED - 'AS BUILT'	[redacted]
8	[redacted]	6/7/16	ISSUE FOR TENDER	
7	[redacted]	19/6/16	GENERAL UPDATE	

No.	BY	DATE	REVISION	CHECKED
6	SB	30/5/95	REVISED AS NOTED	
5	PR	24/5/95	LN#66-601/605-LPG REMOVED	GT AH
4	PR	19/4/95	REVISED AS NOTED	GT EJ
3	[redacted]	31/3/95	REVISED AS NOTED	[redacted]
2	[redacted]	10/2/95	APPROVED FOR CONSTRUCTION	
1	[redacted]	27/1/95	RE-ISSUED FOR TENDER	
0	PGN	21/12/94	APPR. FOR TENDER - F037	

	BY	DATE
PROJECT APPR.	[redacted]	9/3/95
DESIGN APPR.	[redacted]	3/5/95
DESIGNED	[redacted]	20/2/95
CHECKED	[redacted]	28/2/95
DRAWN	[redacted]	1/8/94

PLANT GRID NORTH

REV.	DATE	DESCRIPTION	CHECK	TECH APP
1	4SEP25	APPROVED FOR SP2 CONSTRUCTION	[redacted]	
0	31MAR25	APPROVED FOR SP1 CONSTRUCTION		

KCGM GROWTH PROJECT

DRAWING NO.
2000-F66-PID-PR-10005

CLIENT
KALGOORLIE CONSOLIDATED GOLD [redacted]

TITLE
FIMISTON EXPANSION 1994/95
PIPING & INSTRUMENT DIAGRAM
GOLD SMELTING

SIZE B1 | SCALE N.T.S.

REV. No. 0 1 2 3 4 5 6 7 8 9

DRAWING No.
66\Pi\0454